

MAY 07 1997

COMMISSION

LAND CORNER RECORDATION CERTIFICATE  
Filing Requirement of Act 74, Mich. P.A. 1970

RECORDED

1996 DEC 18 AM 11:16

For corners in

Dickinson (Waucedah Twp.) Located In: Corner Code #  
(County)

- |                                    |                           |       |
|------------------------------------|---------------------------|-------|
| 1. Public Land Survey              | T <u>39N</u> R <u>28W</u> | A-7 ✓ |
|                                    | T <u>39N</u> R <u>28W</u> | C-8 ✓ |
|                                    | T _____ R _____           | _____ |
|                                    | T _____ R _____           | _____ |
| 2. Property Controlling in Section | S _____ T _____           | _____ |
|                                    | S _____ T _____           | _____ |
| 3. Miscellaneous Property in Sec.  | S _____ T _____           | _____ |
|                                    | S _____ T _____           | _____ |

REGISTER OF DEEDS  
DICKINSON COUNTY  
IRON MOUNTAIN, MI 49801

Register of Deeds Stamp & File Number

4. Lot No. \_\_\_\_\_, Recorded Plat \_\_\_\_\_  
5. Private Claims \_\_\_\_\_

I, Ewart C. Muller, in a field survey on October 4, 1996 do hereby state that under requirements of P.A. 74, Michigan P.A. of 1970, the corner points mentioned in lines 1 and 2 above were in conformance with regulations and rules therefore as required in the current manual of survey instructions of the United States Department of the Interior, Bureau of Land Management or by a decree of a Court of Law and/or that the corner points mentioned in lines 3, 4 and 5 above were in conformance with the rules of the Michigan Board of Land Surveyors or by a Decree of a Court of Law; established, re-established, monumented, recovered, found as expressed below:

	A	B	C	D	E	F	G	H	I	J	K	L	M
1													
2		6		5		4		3		2		1	
3													
4		7		8		9		10		11		12	
5													
6		18		17		16		15		14		13	
7	●												
8		19	●	20		21		22		23		24	
9													
10		30		29		28		27		26		25	
11													
12		31		32		33		34		35		36	
13													

NOTE: Not more than 2 corners, all in the same town and range, may be recorded on this certificate.

W. Brevoort, D.S. Surveyed Township lines 1847.  
James W. Mullet, D.S. Subdivided Township 1849.

A. Description of original monument and accessories and/or subsequent restoration:

- A-7 Set post corner of Sections 13 & 24 (T39N,R29W). BT's: Y.Pine 24 S22W 13 lks; Sugar 6 N46W 6 lks. (BT's were destroyed by farming.) No evidence of Original corners found. Found 1½" I.Pipe in rock fence & cedar post 10+ feet South of pipe. Both set by unknown parties.
- C-8 Set Quarter Section post(between Sections 19 & 20) BT's: Beech 3 S77E 24 lks; Beech 3 West 12 lks. Corner evidence destroyed by farming. Corner Area owned by same party in Sections 19 & 20.

ACCEPTED BY THE DICKINSON COUNTY  
SURVEY PEER GROUP AS THE OFFICIAL  
CORNER UNDER MICHIGAN PUBLIC ACT  
345 OF 1990 AT A MEETING HELD ON

B. Description of corner evidence found and/or method applied in restoring or reestablishing corner: A-17-96


A-7 Post agrees with distance to centerline of C&NW Ry as marked on Old RR R/W Map (100') & to a found 1. Pine 15.5 Chns South of Section Corner(Possible line tree per Original Field Notes) I accepted the cedar post as the best corner position. (98.95' to centerline of rails.)

C-8 Established corner position by single proportionate measure between Northeast and Southeast corners of Section 19. [Both section corners Monumented in Dickinson County Remonumentation Project.]

C. Description of monument for corner and accessories established to perpetuate locating the position of the corner:

- A-7 Set 3½ inch Stamped Dickinson County Remonumentation corner on 36-inch aluminum rod.  
NBT's: Maple 8 N54E 50.26; Dble R.Oak N89E 11.09; Trple Mpl S01W 15.41; Trpl Mpl 25 N06W 16.31;  
I.Pipe North 10.44. Carsonite Witness post East 2.0.
- C-8 Set 2½ inch stamped Dickinson County Remonumentation corner on 36-inch aluminum rod.  
NBT's: W.Spr. 20 N62E 27.85; W.Pine 18 S80E 43.15; J.Pine 13 S58W 135.20; W. Spr. 21 S78W 119.35.  
Carsonite Witness post East 2.0.  
Note: Bearings Magnetic. Measurement to nail in notch at side of trees.

Signed by Ewart C. Muller #5 Date October 7, 1996  
Surveyor's Michigan License No. 15408

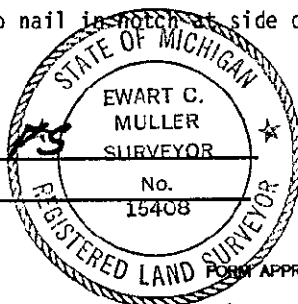

Liber 2 Page 255