

SURVEY & REMONUMENTATION

APR 07 1995

COMMISSION

LAND CORNER RECORDATION CERTIFICATE
Filing Requirement of Act 74, Mich. P.A. 1970

For corners in Dickinson
 (County)

Located In: _____ Corner Code #/

- | | | | | |
|------------------------------------|------------|---------|---------|-------|
| 1. Public Land Survey | Section 28 | T 39N | R 28W | G-9 |
| | | T _____ | R _____ | _____ |
| | | T _____ | R _____ | _____ |
| | | T _____ | R _____ | _____ |
| 2. Property Controlling in Section | S _____ | T _____ | R _____ | _____ |
| | S _____ | T _____ | R _____ | _____ |
| 3. Miscellaneous Property in Sec. | S _____ | T _____ | R _____ | _____ |
| | S _____ | T _____ | R _____ | _____ |

REGISTER OF DEEDS
 REGISTERED TO COUNTY
 REGISTERED TO COUNTY

1994 DEC -9 PM 3:44

RECORDED

Register of Deeds Stamp & File Number

4. Lot No. _____, Recorded Plat _____
 5. Private Claims _____

Section corner to 21, 22, 27 & 28

| | A | B | C | D | E | F | G | H | I | J | K | L | M |
|----|----|----|----|----|----|----|---|---|---|---|---|---|---|
| 2 | 6 | 5 | 4 | 3 | 2 | 1 | | | | | | | |
| 3 | | | | | | | | | | | | | |
| 4 | 7 | 8 | 9 | 10 | 11 | 12 | | | | | | | |
| 5 | | | | | | | | | | | | | |
| 6 | 13 | 17 | 16 | 15 | 14 | 13 | | | | | | | |
| 7 | | | | | | | | | | | | | |
| 8 | 19 | 20 | 21 | 22 | 23 | 24 | | | | | | | |
| 9 | | | | | | | | | | | | | |
| 10 | 30 | 29 | 28 | 27 | 26 | 25 | | | | | | | |
| 11 | | | | | | | | | | | | | |
| 12 | 31 | 32 | 33 | 34 | 35 | 36 | | | | | | | |
| 13 | | | | | | | | | | | | | |

I, John R. Garske, in a field survey on October 10, 1994, do hereby certify that under requirements of P.A. 74, Michigan P.A. of 1970, the corner points mentioned in lines 1 and 2 above were in conformance with regulations and rules therefore as required in the current manual of survey instructions of the United States Department of the Interior, Bureau of Land Management or by a decree of a Court of Law and/or that the corner points mentioned in lines 3, 4 and 5 above were in conformance with the rules of the Michigan Board of Land Surveyors or by a Decree of a Court of Law; established, re-established, monumented, re-monumented, recovered, found as expressed below:

NOTE: Not more than 4 corners, all in the same town and range, may be recorded on this certificate.

A. Description of original monument and accessories and/or subsequent restoration:

Original survey by James H. Mullet. D.S., in August 1849. Set post. Original bearing trees: hemlock 14 - N37°E, 56 links; Birch 18" - S49°E, 26 links.

1935± - W.C. Johnson traversed to corner. Doesn't say what he found.

Neal Sperhake, RLS, used fence intersection, no date, to proportion several other corners.

B. Description of corner evidence found and/or method applied in restoring or reestablishing corner:

Found fence line intersection used by Neal Sperhake, RLS. Since Sperhake used this fence intersection to establish several other corners of record, I am accepting the intersection of fence lines as corner position. Distances to other known corners check well.


ACCEPTED BY THE DICKINSON COUNTY SURVEY PEER GROUP AS THE OFFICIAL CORNER UNDER MICHIGAN PUBLIC ACT 345 OF 1990 AT A MEETING HELD ON 1-23-95
RJP
 COUNTY REPRESENTATIVE

C. Description of monument for corner and accessories established to perpetuate locating the position of the corner:

Set Dickinson County monument at intersection of fence lines running north, east and west and large rock hedgerow running north. Established following references: carsonite rail - N'y, 1.4 feet; 8" sugar maple - N08°E, 26.05 feet; 7" sugar maple - S72°E, 22.13 feet; 9" sugar maple - S36°W, 10.57 feet; 6" sugar maple - S85°W, 23.88 feet.

Signed by John R. Garske
 Surveyor's Michigan License No. 28410

Date 12/8/94

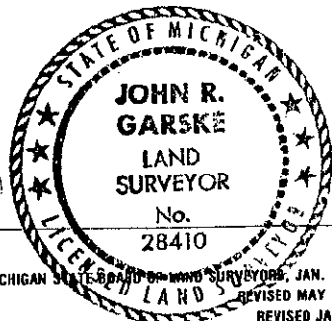

FORM APPROVED BY MICHIGAN STATE BOARD OF LAND SURVEYORS, JAN. 28, 1971
 REVISED MAY 14, 1975
 REVISED JAN., 1983

Line 2

G-9

Page 126