SURVEY &
REMONUMENTATION

APR 27 1995

COMMISSION

LAND CORNER RECORDATION CERTIFICATE

Filing Requirement of Act 74, Mich. P.A. 1970

For corners in

Dickinson (County)

	Located In:	Corner Code -77
1. Public Land Survey	T 39N R 28W	G-7 & H-7
	T ___ R ___	
	T ___ R ___	
	T ___ R ___	
2. Property Controlling	S ___ T ___ R ___	
in Section	S ___ T ___ R ___	
3. Miscellaneous	S ___ T ___ R ___	
Property in Sec.	S ___ T ___ R ___	

RECORDED 1994 SEP -8 AM 8:51 REGISTER OF DEEDS DICKINSON COUNTY, MICH.

Register of Deeds Stamp & File Number

4. Lot No. _____, Recorded Plat _____
5. Private Claims _____

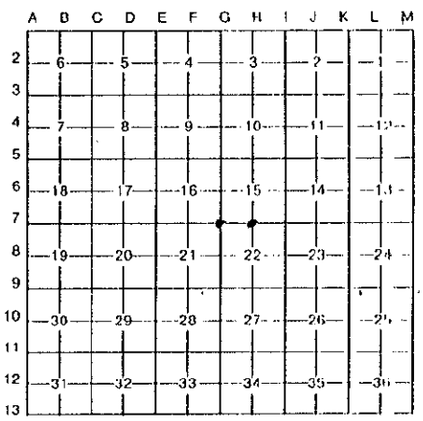

I, Edward Kazianka, in a field survey on June 9, 1994, do hereby certify that under requirements of P.A. 74, Michigan P.A. of 1970, the corner points mentioned in lines 1 and 2 above were in conformance with regulations and rules therefore as required in the current manual of survey instructions of the United States Department of the Interior, Bureau of Land Management or by a decree of a Court of Law and/or that the corner points mentioned in lines 3, 4 and 5 above were in conformance with the rules of the Michigan Board of Land Surveyors or by a Decree of a Court of Law; established, re-established, monumented, re-monumented, recovered, found as expressed below:

NOTE: Not more than 4 corners, all in the same town and range, may be recorded on this certificate.

A. Description of original monument and accessories and/or subsequent restoration:

G-7 Wood Post Sugar 10 S50E 20 lks. W. Pine 24 N55W 07 lks.
One inch iron rod previously recorded in County Corner Book.

H-7 Wood Post Ironwood 10 N15E 20 lks. Hemlock 12 S80W 24 lks.

B. Description of corner evidence found and/or method applied in restoring or reestablishing corner:

G-7 One inch iron rod previously recorded. Set a County corner in place of the rod.

H-7 Section corners ½ mile east and west are set. 1.2 feet north and 1.3 feet east of the mid-point between the section corners found a six inch stove-pipe filled with concrete with a ½ inch iron pin at it's center marked " ¼ ". Accepted it as marking the Quarter Corner and replaced it with a County corner.

ACCEPTED BY THE DICKINSON COUNTY SURVEY PEER GROUP AS THE OFFICIAL CORNER UNDER MICHIGAN PUBLIC ACT 345 OF 1990 AT A MEETING HELD ON 9-7-94

COUNTY REPRESENTATIVE

C. Description of monument for corner and accessories established to perpetuate locating the position of the corner:

G-7 2½ inch Alum. cap on a 3 foot Alum. rod.
Cedar 7 N77W 9.95 feet. Cedar 5 S78W 17.95 feet. Cedar 9 N39E 38.90 feet.
Maple 4 S15E 5.78 feet. Rotten Pine stump in place for Original C.C.

H-7 2½ inch Alum. cap on a 3 foot Alum. rod.
Maple 32 S66E 67.75 feet. Maple 5 S17E 10.49 feet.
Scotch Pine 6 S80W 22.82 feet. Ironwood 4 S30E 16.47 feet.
℄ of Hwy U.S. 2 North 58.2 feet.

STATE OF MICHIGAN EDWARD KAZIANKA LAND SURVEYOR No. 14765 REGISTERED LAND SURVEYOR

Signed by Edward Kazianka Date August 10, 1994

Surveyor's Michigan License No. 14765

FORM APPROVED BY MICHIGAN STATE BOARD OF LAND SURVEYORS, JAN. 26, 1971 REVISED MAY 14, 1975 REVISED JAN. 1993

Liber 2 | Page 99