

LAND CORNER RECORDATION CERTIFICATE

RECORDED

Filing Requirement of Act 74, Mich. P.A. 1970 1999 SEP 20 PM 12: 55

For corners in

Dickinson

(County)

Waucedah Twsp.

Located In:

Corner Code #

1. Public Land Survey

T 39N R 28W

K-7

T R

T R

T R

S T R

2. Property Controlling in Section

S T R

3. Miscellaneous

S T R

Property in Sec.

S T R

MAR 24 2000

SECTION

REGISTER OF DEEDS
DICKINSON COUNTY
RON MOYER, CLERK

Register of Deeds Stamp & File Number

4. Lot No. _____, Recorded Plat _____

5. Private Claims _____

	A	B	C	D	E	F	G	H	I	J	K	L	M
2	6		5		4		3		2		1		
3													
4	7		8		9		10		11		12		
5													
6	18		17		16		15		14		13		
7													
8	19		20		21		22		23		24		
9													
10	30		29		28		27		26		25		
11													
12	31		32		33		34		35		36		
13													

I, Edward Kazianka, in a field survey on June 8, 1999, do hereby certify that under requirements of P.A. 74, Michigan P.A. of 1970, the corner points mentioned in lines 1 and 2 above were in conformance with regulations and rules therefore as required in the current manual of survey instructions of the United States Department of the Interior, Bureau of Land Management or by a decree of a Court of Law and/or that the corner points mentioned in lines 3, 4 and 5 above were in conformance with the rules of the Michigan Board of Land Surveyors or by a Decree of a Court of Law; established, re-established, monumented, re-monumented, recovered, found as expressed below:

NOTE: Not more than 4 corners, all in the same town and range, may be recorded on this certificate.

A. Description of original monument and accessories and/or subsequent restoration:

K-7 Corner common to Sections 13, 14, 23 & 24.
Post by James H. Mullett, D.S. 1849.
Beech 6 S62W 17 lks.
" 8 N60W 32 lks.

B. Description of corner evidence found and/or method applied in restoring or reestablishing corner:

K-7 Found 1 1/2" Iron Pipe recorded by Neil Hill, #27447, in 1981.
Ash 10 S75E 19.90 ft. Maple 8 S30E 24.13 ft.
Maple 6 S40W 11.66 ft. W. Birch 10 S75W 46.64 ft.
(Bk. 1 Page 314)


ACCEPTED BY THE DICKINSON COUNTY SURVEY PEER GROUP AS THE OFFICIAL CORNER UNDER MICHIGAN PUBLIC ACT 345 OF 1990 AT A MEETING HELD ON

9-15-99

Robert G. Fisher
COUNTY REPRESENTATIVE

C. Description of monument for corner and accessories established to perpetuate locating the position of the corner:

K-7 Accepted Iron Pipe described above. Cemented stamped 2 1/2" D.C.
Remon. Corner inside the 1 1/2" Iron pipe.
P. Pole N27E 71.15 ft. 4 1/2" Iron Gate Post N 1W 66.10 ft.
Ironwood 11 S73E 19.80 ft. Maple 9 S26E 23.82 ft.
Maple 7 S45W 11.60 ft.
Carsonite Stake South 1.95 ft.

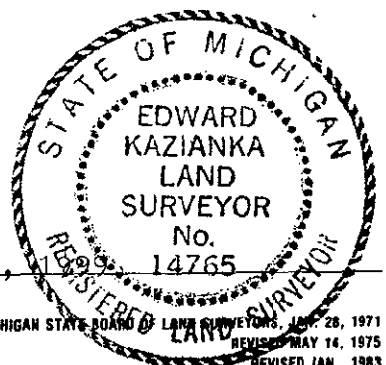

Signed by Edward Kazianka

Date September 8, 1999

Surveyor's Michigan License No. 14765

Suber 2

Page 464