

SURVEY & REMONUMENTATION

APR 07 1995

LAND CORNER RECORDATION CERTIFICATE
Filing Requirement of Act 74, Mich. P.A. 1970

For corners in

Dickinson

(County)

Located In:

Corner Code #

1. Public Land Survey Section 24T 39N R 28W L-7
- T _____ R _____
- T _____ R _____
- T _____ R _____
2. Property Controlling S _____ T _____ R _____
in Section S _____ T _____ R _____
3. Miscellaneous S _____ T _____ R _____
Property in Sec. S _____ T _____ R _____

REGISTERED OFFICERS
DICKINSON COUNTY
REGISTERED SURVEYORS

1994 DEC -9 PM 3:45

RECORDED

Register of Deeds Stamp & File Number

4. Lot No. _____, Recorded Plat _____
5. Private Claims _____
1/4 corner Sections 13 and 24

	A	B	C	D	E	F	G	H	I	J	K	L	M
2	6	5	4	3	2	1							
3													
4	7	8	9	10	11	12							
5													
6	18	17	16	15	14	13							
7													
8	19	20	21	22	23	24							
9													
10	30	29	28	27	26	25							
11													
12	31	32	33	34	35	36							
13													

I, John R. Garske, in a field survey on October 24, 19 94, do hereby certify that under requirements of P.A. 74, Michigan P.A. of 1970, the corner points mentioned in lines 1 and 2 above were in conformance with regulations and rules therefore as required in the current manual of survey instructions of the United States Department of the Interior, Bureau of Land Management or by a decree of a Court of Law and/or that the corner points mentioned in lines 3, 4 and 5 above were in conformance with the rules of the Michigan Board of Land Surveyors or by a Decree of a Court of Law; established, re-established, monumented, re-monumented, recovered, found as expressed below:

NOTE: Not more than 4 corners, all in the same town and range, may be recorded on this certificate.

A. Description of original monument and accessories and/or subsequent restoration:

Original survey by James H. Mullet, D.S., in August 1849. Set post B.T.s: hemlock 8" - N25°E, 9 links; sugar 10" - S20°E, 13 links.

1935 - W.C. Johnson traversed south line of Section 13 and measured to 1/4 corner. Didn't say what was found, but noted that corner was 22.0 feet north of P.I. of road.

1981 - Robert Perkins P.A. 132 survey shows found iron bar at 1/4 corner.

B. Description of corner evidence found and/or method applied in restoring or reestablishing corner:

Found a 1" iron pipe, 23 feet± north of the road centerline. I am accepting the 1" iron pipe as marking the corner position. The pipe has been used and accepted for many years and is shown on several surveys.


ACCEPTED BY THE DICKINSON COUNTY SURVEY PEER GROUP AS THE OFFICIAL CORNER UNDER MICHIGAN PUBLIC ACT 345 OF 1990 AT A MEETING HELD ON 1-23-95
R.P.P.
COUNTY REPRESENTATIVE

C. Description of monument for corner and accessories established to perpetuate locating the position of the corner:

Replaced 1" iron pipe with Dickinson County aluminum monument. Established following references: carsonite rail - North, 1.9 feet; 8" spruce - N69°E, 17.80 feet; 4" spruce - S37°W, 72.47 feet; 7" cedar - N70°W, 32.17 feet; 10" cedar existing - N30°W, 18.49 feet; gravel road centerline 23 feet± south of monument.

Signed by John R. Garske
Surveyor's Michigan License No. 28410

Date 12/8/94

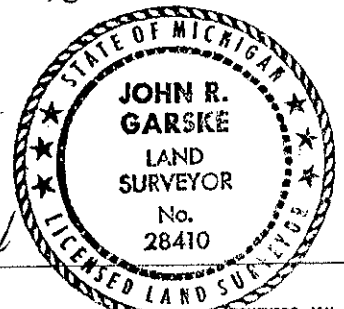

Sheet 2

L-7

Page 135