

DEC 18 1995

RECORDED

COMMISSION

LAND CORNER RECORDATION CERTIFICATE
Filing Requirement of Act 74, Mich. P.A. 1970

1995 NOV 21 AM 11:26


For corners in
Dickinson

(County)

Located In:

Corner Code #

- 1. Public Land Survey T 39N R 29W
T _____ R _____
T _____ R _____
T _____ R _____
- 2. Property Controlling S _____ T _____ R _____
in Section S _____ T _____ R _____
- 3. Miscellaneous S _____ T _____ R _____
Property in Section S _____ T _____ R _____

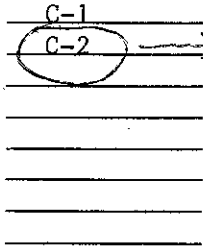

REGISTER OF DEEDS
MICHIGAN COUNTY
PROPERTY

Register of Deeds Stamp & File Number

- 4. Lot No. _____, Recorded Plat _____
- 5. Private Claims _____

	A	B	C	D	E	F	G	H	I	J	K	L	M
2	6		5		4		3		2		1		
3													
4	7		8		9		10		11		12		
5													
6	18		17		16		15		14		13		
7													
8	18		20		21		22		23		24		
9													
10	30		29		28		27		26		25		
11													
12	31		32		33		34		35		36		
13													

I, Robert F. Perkins, in a field survey on Oct. 10, 1995, do hereby certify that under requirements of P.A. 74, Michigan P.A. of 1970, the corner points mentioned in lines 1 and 2 above were in conformance with regulations and rules therefore as required in the current manual of survey instructions of the United States Department of the Interior, Bureau of Land Management or by a decree of a Court of Law and/or that the corner points mentioned in lines 3, 4 and 5 above were in conformance with the rules of the Michigan Board of Professional Surveyors or by a Decree of a Court of Law; established, re-established, monumented, re-monumented, recovered, found as expressed below:

NOTE: Not more than 4 corners, all in the same town and range, may be recorded on this certificate.

A. Description of original monument and accessories and/or subsequent restoration:

C-1 Northeast Corner, Section 6
Post J. Mullett 1847
Original Bearing Trees
Sugar 12" N15°E 27 Lks.
Hemlock 8" N42°W 14 Lks.

C-2 East 1/4 Corner, Section 6
Post J. Mullett 1849
Original Bearing Trees
Y.Pine 18" N30°E 15 Lks.
R.Oak 6" N61°W 18 Lks.

ACCEPTED BY THE DICKINSON COUNTY
SURVEY PEER GROUP AS THE OFFICIAL
CORNER UNDER MICHIGAN PUBLIC ACT
345 OF 1990 AT A MEETING HELD ON
11-20-95

RF P

B. Description of corner evidence found and/or method applied in restoring or reestablishing corner:


C-1 No Evidence of Original Corner or Accessories Found.
Found Concrete Monument buried in Road
Per Sheet 50-City of Norway Land Record.
Corner Researched in 1994.

C-2 No Evidence of Original Corner or Accessories Found.
Found 1" Iron Pipe that was placed over
Concrete Monument (buried 36") in 1970.
Corner appears on Sheet 5-F-City of
Norway Land Record.
Corner Researched in 1994.

C. Description of monument for corner and accessories established to perpetuate locating the position of the corner:

C-1 Placed Monument Box over Existing Monument.
Set Stamped D.C. Remon. W.C. S85°E-28.00'
Power Pole S34°E (M.B.) 40.22'
Power Pole #71-2454 S57°W (M.B.) 44.30'
Lynn 3" N79°W (M.B.) 82.75'
Carsonite Marker 0.3' East of W.C.

C-2 Placed Monument Box over Corner.
Corner Recorded in 1995.
See Liber 2, Page 145 for Witnesses.

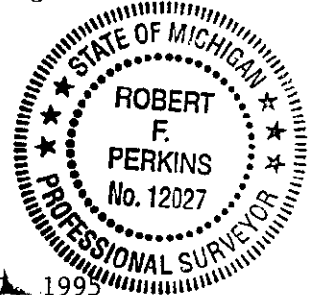

Signed by Robert F. Perkins

Date Nov. 1995

Surveyor's Michigan License No. 12027