

**SURVEY & REMONUMENTATION**

DEC 18 1995

COMMISSION

**LAND CORNER RECORDATION CERTIFICATE**  
Filing Requirement of Act 74, Mich. P.A. 1970

RECORDED

NOV 22 AM 2:31

For corners in

Dickinson (County) Located In: Corner Code ##

1. Public Land Survey	T 39N R 29W	D-5
D-5 8 D-7 17	T 39N R 29W	D-7
17 20	T R	
	T R	
2. Property Controlling in Section	S T R	
	S T R	
3. Miscellaneous Property in Sec.	S T R	
	S T R	
4. Lot No. _____, Recorded Plat _____		
5. Private Claims _____		

REGISTERED DEEDS  
DICKINSON COUNTY

Register of Deeds Stamp & File Number

I, James H. Moore, in a field survey on September 6, 19 95, do hereby certify that under requirements of P.A. 74, Michigan P.A. of 1970, the corner points mentioned in lines 1 and 2 above were in conformance with regulations and rules therefore as required in the current manual of survey instructions of the United States Department of the Interior, Bureau of Land Management or by a decree of a Court of Law and/or that the corner points mentioned in lines 3, 4 and 5 above were in conformance with the rules of the Michigan Board of Land Surveyors or by a Decree of a Court of Law; established, re-established, monumented, re-monumented, recovered, found as expressed below:

**NOTE: Not more than 4 corners, all in the same town and range, may be recorded on this certificate.**

A	B	C	D	E	F	G	H	I	J	K	L	M
2	6		5		4		3		2		1	
3												
4	7		8		9		10		11		12	
5												
6	18		17		16		15		14		13	
7												
8	19		20		21		22		23		24	
9												
10	30		29		28		27		26		25	
11												
12	31		32		33		34		35		36	
13												

**A. Description of original monument and accessories and/or subsequent restoration:**

D-5 Original Corner - Wood Post Set by J. H. Mullet 1849	D-7 Original Corner - Post Set by J. H. Mullet 1849
Original Bearing Trees	Original Bearing Trees
6" Aspen N28°E 5 Links	10" S. Pine S60°E 14 Links
6" Aspen S18°W 4 Links	18" Y. Pine N28°E 35 Links

**B. Description of corner evidence found and/or method applied in restoring or reestablishing corner:**

D-5 Found 5/8" Rebar by Bob Perkins 12027 as Per Sundberg, Carlson's Notes	D-7 Found 1" Iron Pipe at Fence Intersection as Per Sundberg, Carlson's Notes
Fence Lines Run West and South 350' West of Top of Hill	4 Way Fence Corner Tree Line to East
Record Research On File With Register of Deeds	Record Research On File With Register of Deeds


ACCEPTED BY THE DICKINSON COUNTY SURVEY PEER GROUP AS THE OFFICIAL CORNER UNDER MICHIGAN PUBLIC ACT 345 OF 1990 AT A MEETING HELD ON

11-20-95  
ROP

COUNTY REPRESENTATIVE

**C. Description of monument for corner and accessories established to perpetuate locating the position of the corner:**

D-5 Replaced 5/8" Rebar With New Dickinson County Capped Aluminum Monument. Monument Stamped to Identify Corner. Referenced as Follows:	D-7 Drove New Dickinson County Capped Aluminum Monument Inside Existing 1" Iron Pipe. Monument Stamped to Identify Corner. Referenced as Follows:
6" Red Pine N24°E 43.40'	4" Oak N47°E 3.88'
7" Red Pine N71°E 34.23'	5" J. Pine S56°E 6.40'
11" White Pine S63°W 62.18'	Existing 16"
10" Oak N75°W 44.85'	Dead Oak S19°W 21.95'
Carsonite Rail South 1.05'	Existing 14"
	Oak S40°W 42.68'
	6" W. Pine S65°W 25.95'
	Carsonite Rail West 1.0'

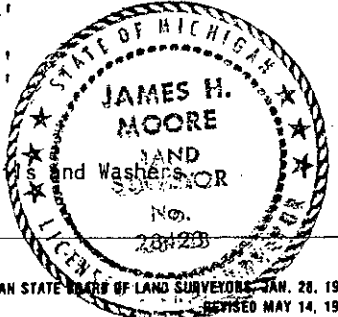

ALL BT's Have 10 d Galv. Nails and Washers

Signed by James H. Moore Date 11/20/95  
Surveyor's Michigan License No. 28423

204