

DEC 18 1995

COMMISSION

RECORDED

LAND CORNER RECORDATION CERTIFICATE
Filing Requirement of Act 74, Mich. P.A. 1970

NOV 22 PM 2:31

For corners in

Dickinson (County)		Located In:	Corner Code #
1. Public Land Survey	T 39N R 29W		L-11
L-11 25 E-7 17 16	T 39N R 29W		E-7
36 20 21	T R		
	T R		
2. Property Controlling in Section	S T R		
	S T R		
3. Miscellaneous Property in Sec.	S T R		
	S T R		
4. Lot No. _____, Recorded Plat _____			
5. Private Claims _____			

ACCEPTED BY NEEDS
DICKINSON COUNTY

Register of Deeds Stamp & File Number

I, James H. Moore, in a field survey on September 6, 19 95, do hereby certify that under requirements of P.A. 74, Michigan P.A. of 1970, the corner points mentioned in lines 1 and 2 above were in conformance with regulations and rules therefore as required in the current manual of survey instructions of the United States Department of the Interior, Bureau of Land Management or by a decree of a Court of Law and/or that the corner points mentioned in lines 3, 4 and 5 above were in conformance with the rules of the Michigan Board of Land Surveyors or by a Decree of a Court of Law; established, re-established, monumented, re-monumented, recovered, found as expressed below:

NOTE: Not more than 4 corners, all in the same town and range, may be recorded on this certificate.

A	B	C	D	E	F	G	H	I	J	K	L	M
2	6	5	4	3	2	1						
3												
4	7	8	9	10	11	12						
5												
6	18	17	16	15	14	13						
7												
8	19	20	21	22	23	24						
9												
10	30	29	28	27	26	25						
11												
12	31	32	33	34	35	36						
13												

A. Description of original monument and accessories and/or subsequent restoration:

L-11 Original Corner - Post Set by J. H. Mullet 1849	E-7 Original Corner - Post Set by J. H. Mullet October 1849
Original Bearing Trees	Original Bearing Trees
10" Sugar S28°E 21 Links	12" Y. Pine S37°W 78 Links
14" Hemlock N83°E 30 Links	18" Y. Pine N30°E 35 Links


B. Description of corner evidence found and/or method applied in restoring or reestablishing corner:

L-11 Found 1/2" Iron at Fence Corner as Per Sundberg, Carlson's Notes	E-7 Sundberg, Carlson Found Concrete Monument. Monument Was Used in Previous Survey's Dating Back to 1915.
Fence Intersection North-South and East, Top of Hill at Corner of Tree Line	East Side of Road, Gravel Drive to The West
Record Research On File With Register of Deeds	

ACCEPTED BY THE DICKINSON COUNTY SURVEY PEER GROUP AS THE OFFICIAL CORNER UNDER MICHIGAN PUBLIC ACT 345 OF 1990 AT A MEETING HELD ON 11-20-95
R.H.P.
COUNTY REPRESENTATIVE

C. Description of monument for corner and accessories established to perpetuate locating the position of the corner:

L-11 Replaced 1/2" Iron With New Dickinson County Capped Aluminum Monument. Monument Stamped to Identify Corner. Referenced as Follows;	E-7 Set New Dickinson Aluminum Capped Monument. Cemented Monument on Iron Pin Protruding from Old Monument. Monument Stamped to Identify Corner. Referenced as Follows:
4" Sugar N30°E 48.81'	S. Stone Gate Post SW Corner N04°E 37.60'
4" Sugar N88°E 36.14'	14" Cedar N68°E 50.32'
4" Sugar South 4.20'	Power Pole S37°W 9.44'
Carsonite Rail East 0.6'	Telephone Riser N85°W 61.50'
8" W. Birch N45°E 21.20'	S. Side Fence Post N86°W 66.4'

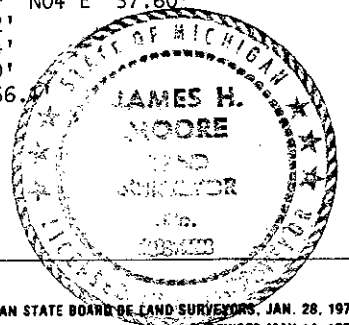

Signed by James H. Moore
Surveyor's Michigan License No. 28423

Date 11/20/95

200