

**SURVEY &
REMONUMENTATION**

DEC 18 1995

COMMISSION

LAND CORNER RECORDATION CERTIFICATE
Filing Requirement of Act 74, Mich. P.A. 1970

RECORDED

NOV 21 AM 11:25

For corners in

Dickinson
(County)

Located In:

Corner Code #

- | | | | | | | |
|---|---|------------|---|------------|------------|-------|
| 1. Public Land Survey | T | <u>39N</u> | R | <u>29W</u> | <u>I-2</u> | |
| | T | _____ | R | _____ | _____ | |
| | T | _____ | R | _____ | _____ | |
| | T | _____ | R | _____ | _____ | |
| 2. Property Controlling
in Section | S | _____ | T | _____ | R | _____ |
| | S | _____ | T | _____ | R | _____ |
| 3. Miscellaneous
Property in Section | S | _____ | T | _____ | R | _____ |
| | S | _____ | T | _____ | R | _____ |

13504
RECORDED AS PER
MICHIGAN COUNTY
RECORDS

Register of Deeds Stamp & File Number

4. Lot No. _____, Recorded Plat _____
5. Private Claims _____

$\frac{1}{4}$ Corner Common to Sections 3/2

I, **Robert F. Perkins** in a field survey on Feb. 27, 19 95, do hereby certify that under requirements of P.A. 74, Michigan P.A. of 1970, the corner points mentioned in lines 1 and 2 above were in conformance with regulations and rules therefore as required in the current manual of survey instructions of the United States Department of the Interior, Bureau of Land Management or by a decree of a Court of Law and/or that the corner points mentioned in lines 3, 4 and 5 above were in conformance with the rules of the Michigan Board of Professional Surveyors or by a Decree of a Court of Law; established, re-established, monumented, re-monumented, recovered, found as expressed below:

A	B	C	D	E	F	G	H	I	J	K	L	M
2	6	5	4	3	2	1						
3												
4	7	8	9	10	11	12						
5												
6	18	17	16	15	14	13						
7												
8	19	20	21	22	23	24						
9												
10	30	29	28	27	26	25						
11												
12	31	32	33	34	35	36						
13												

NOTE: Not more than 4 corners, all in the same town and range, may be recorded on this certificate.

A. Description of original monument and accessories and/or subsequent restoration:

Original Corner by J.H. Mullett, D.S.

Fir 6" N26°E 13.1 L.

Fir 6" S31°E 11.1 L.

Corner falls in Blacktop Road.

No Original Evidence Remains.

B. Description of corner evidence found and/or method applied in restoring or reestablishing corner:

Found Rail Spike 5" below Asphalt 1.6' South of Road Centerline at Location indicated on D.C.R.C. ROW Map. A-8 No. 45 1934

Corner shown on numerous prior Surveys and accepted as best available evidence of Corner location.

ACCEPTED BY THE DICKINSON COUNTY SURVEY PEER GROUP AS THE OFFICIAL CORNER UNDER MICHIGAN PUBLIC ACT 345 OF 1990 AT A MEETING HELD ON

11/6/95

ROF
COUNTY REPRESENTATIVE

C. Description of monument for corner and accessories established to perpetuate locating the position of the corner:

Rail Spike noted above.


Set Stamped Witness Corner 33.00 South on Section Line.

Power Pole #80-2371 S48°E (M.B.) 47.88'

Cherry 6" N55°W (M.B.) 90.12'

Cedar 3" S1°E (M.B.) 58.02'

Iron Bar South 266.22' (on Section Line)

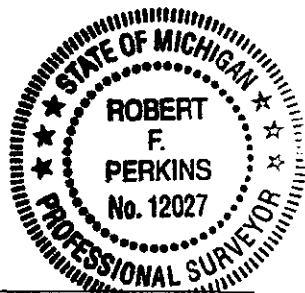

Signed by Robert F. Perkins

Date Feb. 3, 1995

Surveyor's Michigan License No. 12027