

DEC 18 1995

COMMISSION

LAND CORNER RECORDATION CERTIFICATE  
Filing Requirement of Act 74, Mich. P.A. 1970

RECORDED  
035 NOV 22 PM 2:31

For corners in

Dickinson \_\_\_\_\_  
(County)

Located In: \_\_\_\_\_ Corner Code # \_\_\_\_\_

1. Public Land Survey T 39N R 29W 1-7  
I-7 15 14 I-6 15 14 T 39N R 29W 1-6  
22 23 T \_\_\_\_\_ R \_\_\_\_\_  
T \_\_\_\_\_ R \_\_\_\_\_

2. Property Controlling S \_\_\_\_\_ T \_\_\_\_\_ R \_\_\_\_\_  
in Section S \_\_\_\_\_ T \_\_\_\_\_ R \_\_\_\_\_

3. Miscellaneous S \_\_\_\_\_ T \_\_\_\_\_ R \_\_\_\_\_  
Property in Sec. S \_\_\_\_\_ T \_\_\_\_\_ R \_\_\_\_\_

4. Lot No. \_\_\_\_\_, Recorded Plat \_\_\_\_\_

5. Private Claims \_\_\_\_\_

Register of Deeds Stamp & File Number

I, James H. Moore, in a field survey on September 6, 1995, do hereby certify that under requirements of P.A. 74, Michigan P.A. of 1970, the corner points mentioned in lines 1 and 2 above were in conformance with regulations and rules therefore as required in the current manual of survey instructions of the United States Department of the Interior, Bureau of Land Management or by a decree of a Court of Law and/or that the corner points mentioned in lines 3, 4 and 5 above were in conformance with the rules of the Michigan Board of Land Surveyors or by a Decree of a Court of Law; established, re-established, monumented, re-monumented, recovered, found as expressed below:

**NOTE: Not more than 4 corners, all in the same town and range, may be recorded on this certificate.**

| A  | B  | C  | D  | E  | F  | G  | H | I | J | K | L | M |
|----|----|----|----|----|----|----|---|---|---|---|---|---|
| 2  | 6  | 5  | 4  | 3  | 2  | 1  |   |   |   |   |   |   |
| 3  |    |    |    |    |    |    |   |   |   |   |   |   |
| 4  | 7  | 8  | 9  | 10 | 11 | 12 |   |   |   |   |   |   |
| 5  |    |    |    |    |    |    |   |   |   |   |   |   |
| 6  | 18 | 17 | 16 | 15 | 14 | 13 |   |   |   |   |   |   |
| 7  |    |    |    |    |    |    |   |   |   |   |   |   |
| 8  | 19 | 20 | 21 | 22 | 23 | 24 |   |   |   |   |   |   |
| 9  |    |    |    |    |    |    |   |   |   |   |   |   |
| 10 | 30 | 29 | 28 | 27 | 26 | 25 |   |   |   |   |   |   |
| 11 |    |    |    |    |    |    |   |   |   |   |   |   |
| 12 | 31 | 32 | 33 | 34 | 35 | 36 |   |   |   |   |   |   |
| 13 |    |    |    |    |    |    |   |   |   |   |   |   |

A. Description of original monument and accessories and/or subsequent restoration:

I-7 Original Corner - Post Set by J. H. Mullet 1849 Original Bearing Trees  
10" W. Pine N70°W 22 Links  
8" S. Pine N70°E 10 Links

I-6 Original Corner - Post Set by J. H. Mullet 1849 Original Bearing Trees  
24" Y. Pine S55°W 18 Links  
12" Y. Pine N45°E 30 Links

B. Description of corner evidence found and/or method applied in restoring or reestablishing corner:

I-7 Found 5/8" Rebar as Per Sundberg, Carlson's Notes  
3' West of Mailbox, West County Road 577 22.59'  
Record Research On File With Register of Deeds


I-6 Found Punched Rail Road Spike in Centerline Road as Per Sundberg, Carlson's Notes  
Centerline of County Road 577 and 20' North of Centerline of Brickyard Road  
Record Research On File With Register of Deeds

ACCEPTED BY THE DICKINSON COUNTY SURVEY PEER GROUP AS THE OFFICIAL CORNER UNDER MICHIGAN PUBLIC ACT 345 OF 1990 AT A MEETING HELD ON 11-20-95  
R.S.P.  
COUNTY REPRESENTATIVE

C. Description of monument for corner and accessories established to perpetuate locating the position of the corner:

I-7 Replaced 5/8" Rebar With New Dickinson County Capped Aluminum Monument. Monument Stamped to Identify Corner. Referenced as Follows:  
Power Pole N65°E 59.84'  
CL 577 East 22.59'  
Power Pole S11°E 200.67'  
Power Pole N01°E 141.06'  
Carsonite Rail West 0.9'  
Fence Post S. Side of Gate N40°W 30.9'

I-6 Set New Dickinson County Capped Aluminum Monument Box. Monument Stamped to Identify Corner. Referenced as Follows:  
Carsonite Rail & Reference Monument N71°E 64.95'  
Power Pole S53°E 56.28'  
Guard Rail S06°E 68.75'  
Guard Rail S40°W 55.32'  
Guard Rail N68°W 31.12'

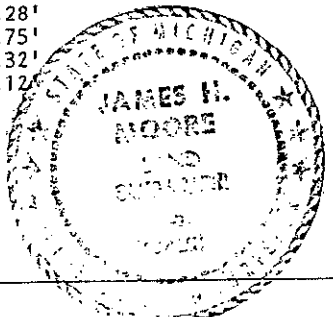

Signed by James H. Moore

Date 11/20/95

Surveyor's Michigan License No. 28423

199