

DEC 18 1995

COMMISSION

LAND CORNER RECORDATION CERTIFICATE
Filing Requirement of Act 74, Mich. P.A. 1970

RECORDED

1995 NOV 22 PM 2:31

For corners in

Form with fields for Dickinson (County), Located In, Corner Code #, and numbered sections 1-5 for Public Land Survey, Property Controlling, Miscellaneous, Lot No., and Private Claims.

Register of Deeds Stamp & File Number

I, James H. Moore, in a field survey on September 6, 1995, do hereby certify that under requirements of P.A. 74, Michigan P.A. of 1970, the corner points mentioned in lines 1 and 2 above were in conformance with regulations and rules therefore as required in the current manual of survey instructions of the United States Department of the Interior, Bureau of Land Management or by a decree of a Court of Law and/or that the corner points mentioned in lines 3, 4 and 5 above were in conformance with the rules of the Michigan Board of Land Surveyors or by a Decree of a Court of Law; established, re-established, monumented, re-monumented, recovered, found as expressed below:

Grid table with columns A-L and rows 1-13, showing a grid of numbers and corner markers.

NOTE: Not more than 4 corners, all in the same town and range, may be recorded on this certificate.

A. Description of original monument and accessories and/or subsequent restoration:

- List of original monuments: L-1 Original Corner - Post Set by H. Brevoort, G-6 Original Corner - Post Set by J. H. Mullet October 1849, and their respective bearings and link lengths.

B. Description of corner evidence found and/or method applied in restoring or reestablishing corner:

- List of corner evidence: L-1 Sundberg, Carlson Found 1 1/2" Drill Steel, Suggested Accepting 1 1/2" Drill Steel as Found; G-6 Found 1/2" Iron Pin Set by U.P. Engineering 1994 as Per Sundberg, Carlson's Notes.


ACCEPTED BY THE DICKINSON COUNTY SURVEY PEER GROUP AS THE OFFICIAL CORNER UNDER MICHIGAN PUBLIC ACT 345 OF 1990 AT A MEETING HELD ON 11-20-95 R.O.P. COUNTY REPRESENTATIVE

C. Description of monument for corner and accessories established to perpetuate locating the position of the corner:

- List of monuments: L-1 Set New Dickinson County Capped Aluminum Monument Next to Existing Pin. Monument Stamped to Identify Corner. Referenced as Follows: Te1 Ped, Power Pole, 4" Cedar, 12" Cedar, Carsonite Rail; G-6 Set New Dickinson County Capped Aluminum Monument in New Monument Box. Monument Stamped to Identify Corner. Referenced as Follows: Power Pole, Power Pole, 10" Tamarack, Carsonite Rail - Reference Monument.

Signed by James H. Moore, Surveyor's Michigan License No. 28423

Date 11/20/95

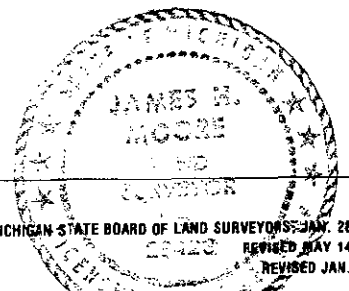

195