

SURVEY &
REMONUMENTATION

MAR 03 1998

LAND CORNER RECORDATION CERTIFICATE

Filing Requirement of Act 74, Mich. P.A. 1970/1997 DEC 10 PM 3:56

RECORDED

For corners in
Dickinson SECTION
(County)

Located In:

Corner Code #

Breitung Twp.


1. Public Land Survey	T	39N	R	30W	G-3
	T		R		L-1
	T		R		
	T		R		
2. Property Controlling in Section	S		T	R	
	S		T	R	
3. Miscellaneous Property in Section	S		T	R	
	S		T	R	

REGISTER OF DEEDS
DICKINSON COUNTY
RON MOULTON, CLERK

Register of Deeds Stamp & File Number

4. Lot No. _____, Recorded Plat _____
5. Private Claims _____

I, Robert F. Perkins, in a field survey on Sept. 30, 1997, do hereby certify that under requirements of P.A. 74, Michigan P.A. of 1970, the corner points mentioned in lines 1 and 2 above were in conformance with regulations and rules therefore as required in the current manual of survey instructions of the United States Department of the Interior, Bureau of Land Management or by a decree of a Court of Law and/or that the corner points mentioned in lines 3, 4 and 5 above were in conformance with the rules of the Michigan Board of Professional Surveyors or by a Decree of a Court of Law; established, re-established, monumented, re-monumented, recovered, found as expressed below:

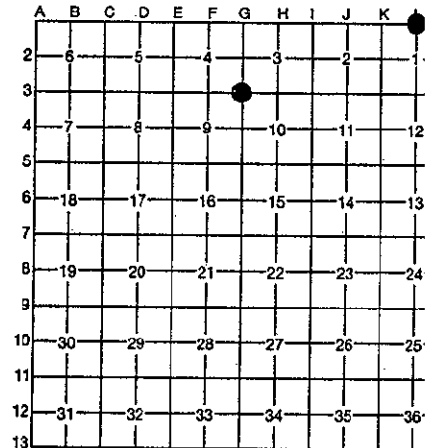

NOTE: Not more than 4 corners, all in the same town and range, may be recorded on this certificate.

A. Description of original monument and accessories and/or subsequent restoration:

G-3	Southwest Corner, Section 3 Post by James Mullett, D.S. 1849 Original Bearing Trees Hemlock 12" S61°E 10 Lks. Hemlock 12" S04°W 23 Lks.	L-1	North 1/4 Corner, Section 1 Post by H. Brevort, D.S. 1848 Original Bearing Trees Aspen 10" N38°E 05 Lks. Aspen 14" N76°W 11 Lks. "Corner on Sidelying Hill Red Sandstone at & near Surface & Descend".
-----	---	-----	---

ACCEPTED BY THE DICKINSON COUNTY SURVEY PEER GROUP AS THE CORNER UNDER MICHIGAN PUBLIC ACT 345 OF 1990 AT A MEETING HELD ON 12-9-97

B. Description of corner evidence found and/or method applied in restoring or reestablishing corner:

G-3	No Evidence of Original Corner or Accessories Found. Found 5/8" ReBar at old Location Tag. Also 2 Existing Cedar Witness Trees. Dug in muck at this location and found possible decayed remnants of Wood Post. Corner shown on Old US-141 Highway Plans and Corner shown on Prior Survey. Corner Researched in 1996 Program	L-1	No Evidence of Original Corner or Accessories Found. Followed Fenceline West from Section Corner. Found 3/4" Iron Pipe projecting ±4" out of Ground. Also 1 Maple Witness Tree. Paint Line with Steel Fence Post runs South from Pipe. Corner is on Sidehill as described in G.L.O. Notes.
-----	--	-----	---

COUNTY REPRESENTATIVE

C. Description of monument for corner and accessories established to perpetuate locating the position of the corner:

G-3	Accept Iron Bar as Best Available Evidence of Corner Location. Set 2 1/2" Stamped D.C. Remon. Corner at Iron Bar. New Witnesses: Cedar 7" N30°E (M.B.) 7.95' Ex. B.T. Cedar 12" S35°W (M.B.) 19.00' Ex. B.T. Cedar 6" S62°W (M.B.) 16.44' Nail/Tag Cedar 6" N53°W (M.B.) 16.75' Nail/Tag Carsonite Marker East 0.4'	L-1	Accept Iron Pipe described above as Best Available Evidence of Corner Location. Replace Pipe with 3 1/2" Stamped D.C. Remon. Corner. New Witnesses: Oak 14" N11°E (M.B.) 22.65' Nail/Tag Oak 14" N75°E (M.B.) 16.26' Nail/Tag Maple 8" S65°W (M.B.) 6.55' Nail/Tag Maple 8" N37°W (M.B.) Ex. B.T.
-----	--	-----	--

Signed by Robert F. Perkins

Date Nov. 21, 1997

Surveyor's Michigan License No. 12027

FORM APPROVED BY MICHIGAN STATE BOARD OF PROFESSIONAL SURVEYORS, JAN. 28, 1971

