

MAY 07 1997

RECORDED

COMMISSION

LAND CORNER RECORDATION CERTIFICATE 1996 DEC 18 AM 11:17  
Filing Requirement of Act 74, Mich. P.A. 1970

For corners in  
DICKINSON

(County)

Located In:

Corner Code #

WAUCEDAHP TWP.

REGISTER OF DEEDS  
DICKINSON COUNTY  
RON MOUNTAIN, MI 49801

- 1. Public Land Survey T 40N R 28W 1-12
- T \_\_\_\_\_ R \_\_\_\_\_
- T \_\_\_\_\_ R \_\_\_\_\_
- T \_\_\_\_\_ R \_\_\_\_\_
- 2. Property Controlling S \_\_\_\_\_ T \_\_\_\_\_ R \_\_\_\_\_
- in Section S \_\_\_\_\_ T \_\_\_\_\_ R \_\_\_\_\_
- 3. Miscellaneous S \_\_\_\_\_ T \_\_\_\_\_ R \_\_\_\_\_
- Property in Section S \_\_\_\_\_ T \_\_\_\_\_ R \_\_\_\_\_

11

Register of Deeds Stamp & File Number

- 4. Lot No. \_\_\_\_\_, Recorded Plat \_\_\_\_\_
- 5. Private Claims \_\_\_\_\_

A	B	C	D	E	F	G	H	I	J	K	L	M
2	6	5	4	3	2	1						
3												
4	7	8	9	10	11	12						
5												
6	18	17	16	15	14	13						
7												
8	19	20	21	22	23	24						
9												
10	30	29	28	27	26	25						
11												
12	31	32	33	34	35	36						
13												

I, ROBERT F. PERKINS, in a field survey on 10-4, 19 96, do hereby certify that under requirements of P.A. 74, Michigan P.A. of 1970, the corner points mentioned in lines 1 and 2 above were in conformance with regulations and rules therefore as required in the current manual of survey instructions of the United States Department of the Interior, Bureau of Land Management or by a decree of a Court of Law and/or that the corner points mentioned in lines 3, 4 and 5 above were in conformance with the rules of the Michigan Board of Professional Surveyors or by a Decree of a Court of Law; established, re-established, monumented, re-monumented, recovered, found as expressed below:

NOTE: Not more than 4 corners, all in the same town and range, may be recorded on this certificate.

A. Description of original monument and accessories and/or subsequent restoration:

1-12 1/4 CORNER COMMON TO SECTIONS 34/35

POST BY J. H. MULLETT 1849  
ORIGINAL BEARING TREES  
CEDAR 12" S65°E 39 L.  
W. PINE 24" S55°W 23 L.

ACCEPTED BY THE DICKINSON COUNTY  
SURVEY PEER GROUP AS THE OFFICIAL  
CORNER UNDER MICHIGAN PUBLIC ACT  
345 OF 1990 AT A MEETING HELD ON

12-17-96

R.F.P.  
COUNTY REPRESENTATIVE

B. Description of corner evidence found and/or method applied in restoring or reestablishing corner:


1-12 NO EVIDENCE OR ORIGINAL CORNER OR ACCESSORIES FOUND.

- 1913 M.J. BACCO FINDS & WITNESSES CEDAR POST BUT QUESTIONS ITS CORRECTNESS.
- 1938 W.C. JOHNSON WITNESSES ABOVE POST: ELM 6" N78°W 39.5'  
ELM 8" S76°W 42.21'
- 1954 D.N.R. NOTES NO TRACE OF CORNER.
- 1996 FIND 1" SQUARE IRON BAR IN WEST WHEEL TRACK OF ROAD. ALSO FIND ELM STUMPS OF W.C. JOHNSON WITNESSES, ALSO BACCO TIES TO OLD BUILDING REMAINS. THESE TIES DO NOT AGREE WITH FOUND IRON BAR.

C. Description of monument for corner and accessories established to perpetuate locating the position of the corner:

1-12 DUE TO CONFLICTING DATA NOTED ABOVE, RAN SECTION LINE FROM SECTION CORNER 1/2 MILE SOUTH TO CORNER 1/2 MILE NORTH = 5347.9'. AT MID-POINT AND ON LINE SET 2 1/2" STAMPED D.C. REMON. CORNER. CORNER FALLS ± 3' EAST OF VERY OLD N-S FENCE LINE & ± 22' WEST OF CENTERLINE DIRT ROAD.

NEW WITNESSES:  
S.E. CORNER CAMP N70°W (M.B.) 78.40'  
N.E. CORNER CAMP N50°W (M.B.) 96.70'  
R. PINE 6" S26°W (M.B.) 47.46' NAIL/TAG  
R. PINE 10" N26°W (M.B.) 22.78' NAIL/TAG  
1" SQ. IRON BAR (Existing) N80°E (M.B.) 17.50'  
CENTERLINE DIRT ROAD EAST ± 22'

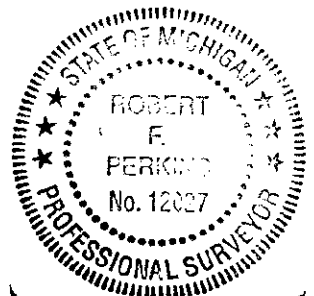

Signed by Robert F. Perkins

Date NOVEMBER 6, 1996

Surveyor's Michigan License No. 12027