

SURVEY &  
REMONUMENTATION

MAR 03 1998

LAND CORNER RECORDATION CERTIFICATE  
Filing Requirement of Act 74, Mich. P.A. 1970

RECORDED

1997 DEC 12 PM 1:36

For corners in SECTION

<u>Dickinson</u>	Located in:	Corner Code #
(County)		
Waucedah Township		
1. Public Land Survey	T40N R 28W	<u>J-11</u>
	T___ R___	K-11
	T___ R___	_____
	T___ R___	_____
2. Property Controlling in Section	S___ T___ R___	_____
	S___ T___ R___	_____
3. Miscellaneous Property in Sec.	S___ T___ R___	_____
	S___ T___ R___	_____

REGISTER OF DEEDS  
DICKINSON COUNTY  
RON MOORE, CLERK

Register of Deeds Stamp & File Number

4. Lot No. \_\_\_\_\_, Recorded Plat \_\_\_\_\_  
5. Private Claims \_\_\_\_\_

I, James H. Moore, in a field survey on September 23, 1997, do hereby state that under requirements of P.A. 74, Michigan P.A. of 1970, the corner points mentioned in lines 1 and 2 above were in conformance with regulations and rules therefore as required in the current manual of survey instructions of the United States Department of the Interior, Bureau of Land Management or by a decree of a Court of Law and for that the corner points mentioned in lines 3, 4 and 5 above were in conformance with the rules of the Michigan Board of Land Surveyors or by a Decree of a Court of Law; established, re-established, monumented, recovered, found as expressed below:

NOTE: Not more than 2 corners, all in the same town and range, may be recorded on this certificate.

A	B	C	D	E	F	G	H	I	J	K	L	M
1												
2	6	5		4		3		2		1		
3												
4	7	8		9		10		11		12		
5												
6	18	17		16		15		14		13		
7												
8	19	20		21		22		23		24		
9												
10	30	29		28		27		26		25		
11												
12	31	32		33		34		35		36		
13												

A. Description of original monument and accessories and/or subsequent restoration:

<u>J-11</u> - 1/4 corner common to Sections 26 and 35 Post by James H. Mullett, D.S. 1849	<u>K-11</u> - corner common to Sections 25, 26, 35 and 36 Post by James H. Mullett, D.S. 1849
Sugar 8" N65°E 11 L. W. Pine 24" S55°W 23 L.	Cedar 15" N41°W 20 L. Cedar 15" S65°W 20 L.
approximate center of road 60 links east	

ACCEPTED BY THE DICKINSON COUNTY SURVEY PEER GROUP AS THE OFFICIAL CORNER UNDER MICHIGAN PUBLIC ACT 345 OF 1990 AT A MEETING HELD ON 12-9-97

R.C.P.

COUNTY REPRESENTATIVE

B. Description of corner evidence found and/or method applied in restoring or reestablishing corner:


<u>J-11</u> - found 1" pipe with 4" DNR cap set by proportionate measure in 1955 by B. Buckler (old #2) 1955 bearing trees:	<u>K-11</u> - found 1" pipe with 4" DNR cap set by in 1951 by D.C. Delamater from found original evidence (old #1) 1951 bearing trees:
Balsam 7" S68°W 65 L. Balsam 11" N60°W 143 L.	Cedar 8" N43°W 8 L. Cedar 8" N85°E 42 L.

C. Description of monument for corner and accessories established to perpetuate locating the position of the corner:

<u>J-11</u> - found above described monument in place New Witnesses:	<u>K-11</u> - found above described monument in place New Witnesses:
Spruce 10" N77°W (M.B.) 19.12' nail/tag Balsam 6" N10°E (M.B.) 3.38' nail/tag Balsam 5" S18°W (M.B.) 18.11' nail/tag P.K. in CL Road East 41.65'	Cedar 8" S25°E (M.B.) 35.02' nail/tag Cedar 11" S53°W (M.B.) 28.46' nail/tag Cedar 9" N31°W (M.B.) 40.00' nail/tag Cedar 4" N80°E (M.B.) 35.15' nail/tag
placed carsonite marker West 1.12'	placed carsonite marker N40°E 1.0'

Signed by James H. Moore  
Surveyor's Michigan License MOORE 28423

Date 12-8-97

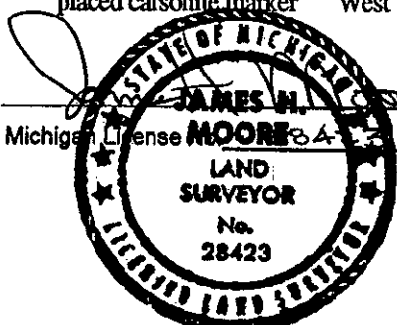

LIBER 002 PAGE 341