

MAY 07 1997

COMMISSION

LAND CORNER RECORDATION CERTIFICATE
Filing Requirement of Act 74, Mich. P.A. 1970

RECORDED

1996 DEC 18 AM 11:17

For corners in DICKINSON (County)

Located In:

Corner Code #

WAUCEDAHP TWP.

- 1. Public Land Survey T 40N R 28W J-5 K 2
2. Property Controlling in Section S T R
3. Miscellaneous S T R
4. Lot No.
5. Private Claims

REGISTER OF DEEDS DICKINSON COUNTY IRON MOUNTAIN, MI. 49801

13

Register of Deeds Stamp & File Number

I, ROBERT F. PERKINS, in a field survey on 10-8, 19 96, do hereby certify that under requirements of P.A. 74, Michigan P.A. of 1970, the corner points mentioned in lines 1 and 2 above were in conformance with regulations and rules therefore as required in the current manual of survey instructions of the United States Department of the Interior, Bureau of Land Management or by a decree of a Court of Law and/or that the corner points mentioned in lines 3, 4 and 5 above were in conformance with the rules of the Michigan Board of Professional Surveyors or by a Decree of a Court of Law; established, re-established, monumented, re-monumented, recovered, found as expressed below:

NOTE: Not more than 4 corners, all in the same town and range, may be recorded on this certificate.

Grid table with columns A-L and rows 1-13. Contains a black dot in cell J-2 and another in cell J-5.

A. Description of original monument and accessories and/or subsequent restoration:

J-5 1/4 CORNER COMMON TO SECTIONS 11 & 14 POST BY J. H. MULLETT, D.S. 1849 ORIGINAL BEARING TREES IRONWOOD 8" N08°W 11 L. ELM 4" S85°E 05 L.

K-2 1/4 CORNER COMMON TO SECTIONS 2/1 POST BY J. H. MULLETT, D.S. 1849 ORIGINAL BEARING TREES W. PINE 14" N69°E 30 L. W. PINE 3 1/2" S01°W THE DICKINSON COUNTY SURVEY PEER GROUP AS THE OFFICIAL CORNER UNDER MICHIGAN PUBLIC ACT 345 OF 1990 AT A MEETING HELD ON 12-17-96 R.F.P. COUNTY REPRESENTATIVE

B. Description of corner evidence found and/or method applied in restoring or reestablishing corner:

J-5 1913 M.J. BACCO WITNESSES CORNER MAPLE 6" S12°E 31.3' MAPLE 8" N56°E 49.0' HEMLOCK 8" N33°E 41.3' 10-8-96 FIND 1/2" RE-ROD AND REMAINS OF ORIGINAL ELM BT NOW A STUMP +/- 30". LOWER BLAZE VISIBLE. ALSO FIND ALL 3 STUMP HOLES OF BACCO BT'S. HEAVY BLAZED LINE RUNS EAST-WEST. PAINT LINE RUNS NORTH. 2 NEWER VISIBLE BT'S EVIDENT.

K-2 FOUND 1 1/2" IRON PIPE FLUSH WITH GROUND. ALSO 1 1/2" IRON PIPE ALONG SIDE PROJECTING 18". ANCIENT FENCE LINE RUNS SOUTH FROM CORNER. DISTANCE CHECKS WITH GLO CALL NORTH TO STURGEON RIVER. R. CAZZOLA, ADJOINING PROPERTY OWNER, STATED HE HAD PERSONAL KNOWLEDGE OF CORNER BEING IN EXISTENCE OVER 50 YEARS.

C. Description of monument for corner and accessories established to perpetuate locating the position of the corner:


J-5 ACCEPTED ABOVE LOCATION. PLACES D.C. REMON. 2 1/2" STAMPED MONUMENT AT RE-ROD. NEW BEARING TREES: MAPLE 8" S34°E (M.B.) 18.30' NAIL/TAG MAPLE 12" S78°W (M.B.) 13.20' NAIL/TAG LYNN 10" S40°W (M.B.) 23.21' NAIL/TAG LYNN 10" N38°E (M.B.) 30.20' NAIL/TAG ELM STUMP 30" S85°E (M.B.) 3.0' (BT) SET CARSONITE MARKER 1.2' N.W. OF CORNER

K-2 ACCEPTED ABOVE DESCRIBED IRON PIPE AS BEST AVAILABLE EVIDENCE OF CORNER LOCATION. PLACED 2 1/2" STAMPED D.C. REMON. MONUMENT INSIDE EXISTING IRON PIPE. NEW BEARING TREES: SPRUCE 7" S45°E (M.B.) 14.24' NAIL/TAG SPRUCE 4" N48°E (M.B.) 24.64' NAIL/TAG SPRUCE 18" N71°E (M.B.) 39.67' NAIL/TAG W.PINE 3" N28°W (M.B.) 82.95' NAIL/TAG PLACED CARSONITE MARKER 1' EAST OF CORNER.

Signed by Robert F. Perkins Surveyor's Michigan License No. 12027

Date NOVEMBER 6, 1996

FORM APPROVED BY MICHIGAN STATE BOARD OF PROFESSIONAL SURVEYORS, JAN 25, 1971

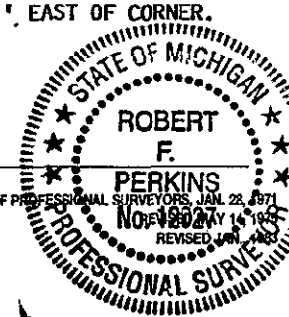

Liber 2

Page 218