

SURVEY & REMONUMENTATION

MAR 03 1998

RECORDED

SECTION

LAND CORNER RECORDATION CERTIFICATE
Filing Requirement of Act 74, Mich. P.A. 1970 1997 DEC 12 PM 1:36

For corners in

Dickinson (County)	Located In:	Corner Code #
Waucedah Township	T 40NR 28W	L-11
1. Public Land Survey	T R	K-12
	T R	
	T R	
	T R	
2. Property Controlling in Section	S T R	
	S T R	
3. Miscellaneous Property in Sec.	S T R	
	S T R	

REGISTER OF DEEDS
DICKINSON COUNTY
RON MOORE, CLERK

Register of Deeds Stamp & File Number

4. Lot No. _____ Recorded Plat _____
5. Private Claims _____

I, James H. Moore, in a field survey on September 22 19 97 do hereby state that under requirements of P.A. 74, Michigan P.A. of 1970, the corner points mentioned in lines 1 and 2 above were in conformance with regulations and rules therefore as required in the current manual of survey instructions of the United States Department of the Interior, Bureau of Land Management or by a decree of a Court of Law and /or that the corner points mentioned in lines 3, 4 and 5 above were in conformance with the rules of the Michigan Board of Land Surveyors or by a Decree of a Court of Law; established, re-established, monumented, recovered, found as expressed below:

NOTE: Not more than 2 corners, all in the same town and range, may be recorded on this certificate.

	A	B	C	D	E	F	G	H	I	J	K	L	M
1													
2	6		5		4		3		2		1		
3													
4	7		8		9		10		11		12		
5													
6	18		17		16		15		14		13		
7													
8	19		20		21		22		23		24		
9													
10	30		29		28		27		26		25		
11													
12	31		32		33		34		35		36		
13													

A. Description of original monument and accessories and/or subsequent restoration:

L-11 - 1/4 corner common to Sections 25 and 36
Post by James H. Mullett, D.S. 1849

Cedar 8" S35°E 15 L.
Cedar 12" N30°E 05 L.

K-12 - 1/4 corner common to Sections 35 and 36
Post by James H. Mullett, D.S. 1849

Aspen 4" N70°W 15 L.
Fir 6" N53°E 12 L.

ACCEPTED BY THE DICKINSON COUNTY SURVEY PEER GROUP AS THE OFFICIAL CORNER UNDER MICHIGAN PUBLIC ACT 345 OF 1990 AT A MEETING HELD ON

12-9-97

ROAR COUNTY REPRESENTATIVE

B. Description of corner evidence found and/or method applied in restoring or reestablishing corner:

L-11 - found 1" pipe with 4" K.C. Corp. aluminum cap set by proportionate measure in 1966 by E. Kazianka (old #1020) 1966 bearing trees:

Spruce 10" N08°E 27-1/2 L.
Aspen 6" S21°E 3-1/2 L.

K-12 - found 1" pipe with 4" K.C. Corp. aluminum cap set by proportionate measure in 1966 by E. Kazianka (old #1028) 1966 bearing trees:

W. Birch 9" S65°W 24-1/2 L.
W. Birch 6" N81°E 16 L.

C. Description of monument for corner and accessories established to perpetuate locating the position of the corner:

L-11 - found above described monument in place
New Witnesses:

Balsam 2" S83°W (M.B.) 23.15' nail/tag
W. Birch 5" N57°W (M.B.) 20.50' nail/tag
Balsam 3" N33°W (M.B.) 14.05' nail/tag
Balsam 3" N40°E (M.B.) 17.12' nail/tag


K-12 - found above described monument in place
New Witnesses:

W. Birch 8" S40°E (M.B.) 15.17' nail/tag
Balsam 3" N70°E (M.B.) 19.95' nail/tag
Balsam 5" N20°E (M.B.) 31.01' nail/tag
Balsam 10" S81°W (M.B.) 11.41' nail/tag

placed carsonite marker S35°E 0.74'

placed carsonite marker S65°E 0.95'

Signed by _____
Surveyor's Michigan License No. _____

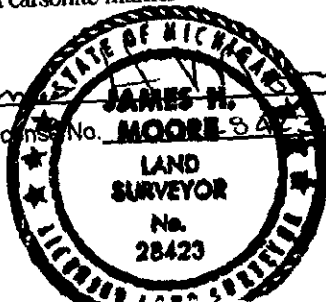

Date 12-8-97

FORM APPROVED BY MICHIGAN STATE BOARD OF PROFESSIONAL SURVEYORS, JAN. 28, 1971
REVISED MAY 14, 1975
REVISED JAN., 1983
REVISED OCT., 1985

LIBER 002 PAGE 342