

SURVEY &
REMONUMENTATION

MAR 03 1998

RECORDED

SECTION

LAND CORNER RECORDATION CERTIFICATE
Filing Requirement of Act 74, Mich. P.A. 1970

1997 DEC 12 PM 1:36

For corners in

Dickinson (County) Waukegan Township	Located In:	Corner Code #
1. Public Land Survey	T 40NR 28W	L-11
	T ___ R ___	K-12
	T ___ R ___	
	T ___ R ___	
2. Property Controlling in Section	S ___ T ___ R ___	
	S ___ T ___ R ___	
3. Miscellaneous Property in Sec.	S ___ T ___ R ___	
	S ___ T ___ R ___	

REGISTER OF DEEDS
DICKINSON COUNTY
RON MOULTON, CLERK

Register of Deeds Stamp & File Number

4. Lot No. _____, Recorded Plat _____
5. Private Claims _____

I, James H. Moore, in a field survey on September 22 19 97 do hereby state that under requirements of P.A. 74, Michigan P.A. of 1970, the corner points mentioned in lines 1 and 2 above were in conformance with regulations and rules therefore as required in the current manual of survey instructions of the United States Department of the Interior, Bureau of Land Management or by a decree of a Court of Law and for that the corner points mentioned in lines 3, 4 and 5 above were in conformance with the rules of the Michigan Board of Land Surveyors or by a Decree of a Court of Law; established, re-established, monumented, recovered, found as expressed below:

NOTE: Not more than 2 corners, all in the same town and range, may be recorded on this certificate.

	A	B	C	D	E	F	G	H	I	J	K	L	M
1													
2	6		5		4		3		2		1		
3													
4	7		8		9		10		11		12		
5													
6	18		17		16		15		14		13		
7													
8	19		20		21		22		23		24		
9													
10	30		29		28		27		26		25		
11													
12	31		32		33		34		35		36		
13													

A. Description of original monument and accessories and/or subsequent restoration:

L-11 - 1/4 corner common to Sections 25 and 36
Post by James H. Mullett, D.S. 1849

K-12 - 1/4 corner common to Sections 35 and 36
Post by James H. Mullett, D.S. 1849

Cedar 8" S35°E 15 L.
Cedar 12" N30°E 05 L.

Aspen 4"
Fir 6"

N70°W 15 L.

ACCEPTED BY THE DICKINSON COUNTY
SURVEY PEER GROUP AS THE OFFICIAL
CORNER UNDER MICHIGAN PUBLIC ACT
345 OF 1990 AT A MEETING HELD ON

12-9-97
R.A.P.

COUNTY REPRESENTATIVE

B. Description of corner evidence found and/or method applied in restoring or reestablishing corner:

L-11 - found 1" pipe with 4" K.C. Corp.
aluminum cap set by proportionate
measure in 1966 by E. Kazianka (old #1020)
1966 bearing trees:

Spruce 10" N08°E 27-1/2 L.
Aspen 6" S21°E 3-1/2 L.

K-12 - found 1" pipe with 4" K.C. Corp.
aluminum cap set by proportionate
measure in 1966 by E. Kazianka (old #1028)
1966 bearing trees:

W. Birch 9" S65°W 24-1/2 L.
W. Birch 6" N81°E 16 L.

C. Description of monument for corner and accessories established to perpetuate locating the position of the corner:

L-11 - found above described monument in place
New Witnesses:

Balsam 2" S83°W (M.B.) 23.15' nail/tag
W. Birch 5" N57°W (M.B.) 20.50' nail/tag
Balsam 3" N33°W (M.B.) 14.05' nail/tag
Balsam 3" N40°E (M.B.) 17.12' nail/tag

placed carsonite marker S35°E 0.74'


K-12 - found above described monument in place
New Witnesses:

W. Birch 8" S40°E (M.B.) 15.17' nail/tag
Balsam 3" N70°E (M.B.) 19.95' nail/tag
Balsam 5" N20°E (M.B.) 31.01' nail/tag
Balsam 10" S81°W (M.B.) 11.41' nail/tag

placed carsonite marker S65°E 0.95'

Signed by

Surveyor's Michigan License No.

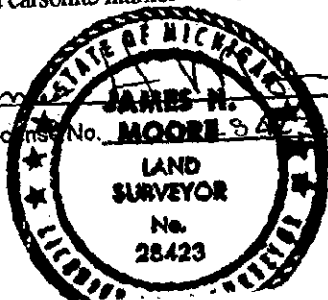

Date

12-8-97