

MAY 07 1997

RECORDED

COMMISSION LAND CORNER RECORDATION CERTIFICATE

1996 DEC 18 AM 11:16

Filing Requirement of Act 74, Mich. P.A. 1970

For corners in

DICKINSON

(County)

Located In:

Corner Code #

WAUCEDAHP TWP.

- 1. Public Land Survey T 40N R 28W M-5
2. Property Controlling in Section S T R
3. Miscellaneous Property in Section S T R

REGISTER OF DEEDS DICKINSON COUNTY RON MOUNTAIN 49801

Register of Deeds Stamp & File Number

- 4. Lot No. Recorded Plat
5. Private Claims

Grid table with columns A-L and rows 1-13 for recording information.

I, ROBERT F. PERKINS, in a field survey on 10-10, 1996 do hereby certify that under requirements of P.A. 74, Michigan P.A. of 1970, the corner points mentioned in lines 1 and 2 above were in conformance with regulations and rules therefore as required in the current manual of survey instructions of the United States Department of the Interior, Bureau of Land Management or by a decree of a Court of Law and/or that the corner points mentioned in lines 3, 4 and 5 above were in conformance with the rules of the Michigan Board of Professional Surveyors or by a Decree of a Court of Law; established, re-established, monumented, re-monumented, recovered, found as expressed below:

NOTE: Not more than 4 corners, all in the same town and range, may be recorded on this certificate.

A. Description of original monument and accessories and/or subsequent restoration:

M-5 SECTION CORNER COMMON TO SECTIONS 7 AND 8, T40N-R27W AND SECTIONS 12 AND 13, T40N-R28W. SET POST ON N. SIDE MARSH J.H. MULLETT 1848 ORIGINAL BEARING TREES ASPEN 10" N15°W 25 L. W.PINE 36" S01°W 30 L.


B. Description of corner evidence found and/or method applied in restoring or reestablishing corner:

M-5 FOUND 1" IRON PIPE WITH 4" MEAD CORP. STAMPED CAP RLS #8317 AT NORTH EDGE OF MARSH. CORNER SET IN 1981.

ACCEPTED BY THE DICKINSON COUNTY SURVEY PEER GROUP AS THE OFFICIAL CORNER UNDER MICHIGAN PUBLIC ACT 345 OF 1990 AT A MEETING HELD ON 12-17-96 R.F.P. COUNTY REPRESENTATIVE

C. Description of monument for corner and accessories established to perpetuate locating the position of the corner:

M-5 ACCEPTED ABOVE DESCRIBED MONUMENT AS BEST AVAILABLE EVIDENCE OF CORNER LOCATION. NEW BEARING TREES: ASPEN 14" N43°E (M.B.) 10.50' TAIL/TAG RED MAPLE 4" N81°E (M.B.) 10.13' NAIL/TAG MAPLE 8" N71°W (M.B.) 44.17' (EXISTING B.T.) DBL. MAPLE N46°W (M.B.) 20.72' NAIL/TAG PLACED CARSONITE MARKER 1' NORTH OF CORNER

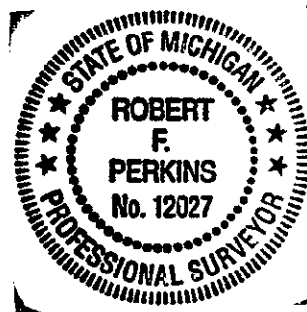

Signed by Robert F. Perkins Date DECEMBER 2, 1996

Surveyor's Michigan License No. 12027