

MICHIGAN  
DEPARTMENT OF CONSERVATION  
FORESTRY DIVISION

LAND CORNER RECORD

T. 40 NR. 28 W.

Dickinson COUNTY

DESCRIPTION OF CORNER 1/4 Section Corner between Sections 10 and 15

DESCRIPTION OF CORNER MONUMENT 1" pipe with 4" brass cap

WITNESSES TO CORNER 12" Yellow Birch N. 24° E 70 links

14" Hemlock S. 81° E 58 links


DESCRIPTION IN DETAIL AS TO HOW CORNER WAS LOCATED AND IDENTIFIED OR RESTORED.

Replace 1/4 Corner between 10-15. This 1/4 corner has been set and re-witnessed by an unknown surveyor about 40 years ago. One Cedar stp. marked B.T. N 30° W , 15 links.

No original witnesses.

Corner placed and witnessed November 17, 1955.

SURVEYORS SEAL

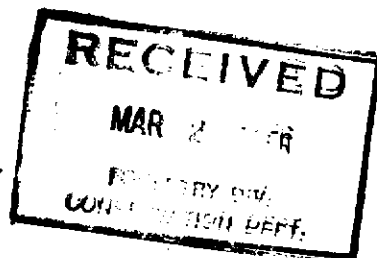

SIGNED Billy D. Buckles  
REGISTERED LAND SURVEYOR

DATE 2/27/56