

MICHIGAN
DEPARTMENT OF CONSERVATION
FORESTRY DIVISION

LAND CORNER RECORD

T. 40. NR. 28. W. . .

----- Dickinson ----- COUNTY

DESCRIPTION OF CORNER . . . 1/4 Section Corner on west side of Section 19 . . .

DESCRIPTION OF CORNER MONUMENT . . . 1" pipe with 4" brass pipe . . .

WITNESSES TO CORNER . . . 6" Cedar . . . S 53° W . . . 53 links . . .

----- 7" Cedar . . . South . . . 9 links . . . -----

DESCRIPTION IN DETAIL AS TO HOW CORNER WAS LOCATED AND IDENTIFIED OR RESTORED.


Set 1/4 Section Corner on West side of Section 19 by proportionate measure N. and S.

1/4 Section Corner is 23 links South and 3 links East of 40.00 ch. marker from North.

No evidence of original 1/4 corner.

There is an old line of blases N. and S. from this location.

Corner placed and witnessed August 17, 1955.

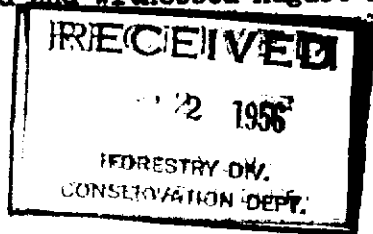

SURVEYORS SEAL

SIGNED Billy D. Buckles DATE 2/27/56
REGISTERED LAND SURVEYOR