

MICHIGAN
DEPARTMENT OF CONSERVATION
FORESTRY DIVISION

LAND CORNER RECORD

T. 40. NR. 28. W. . .

----- Dickinson ----- COUNTY

DESCRIPTION OF CORNER 1/4 Section Corner between Sections 18, 19 -----

DESCRIPTION OF CORNER MONUMENT 1" pipe with 4" brass cap. -----

WITNESSES TO CORNER Str. 30 links E. C-N -----

Elm 8" S 17° E 97 links -----

No other witnesses available -----

DESCRIPTION IN DETAIL AS TO HOW CORNER WAS LOCATED AND IDENTIFIED OR RESTORED.

Set 1/4 Section Corner between 18 and 19 by Proportionate Measure and on a line between two Section Corners.


1/4 Corner set in North edge of old Beaver lodge.

No evidence of original corner.

1/4 Section Corner is 44 links East and 53 links North of 36.00 ch. marker from West.

Corner placed and witnessed August 9, 1955.

SURVEYORS SEAL

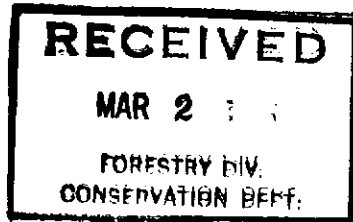

SIGNED Billy D. Duckles ----- DATE 2/27/56 -----
REGISTERED LAND SURVEYOR