

MICHIGAN
DEPARTMENT OF CONSERVATION
FORESTRY DIVISION

LAND CORNER RECORD

T. 40. NR. 28. W.


Dickinson COUNTY

DESCRIPTION OF CORNER North 1/8 corner for Section 24

DESCRIPTION OF CORNER MONUMENT 1" x 48" Iron Pipe

WITNESSES TO CORNER 9" White Pine (B.T.) N 62° W 41 1/2 Links

5" Hard Maple (B.T.) S 56° W 21 Links

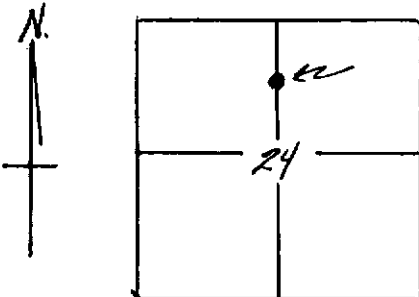

DESCRIPTION IN DETAIL AS TO HOW CORNER WAS LOCATED AND IDENTIFIED OR RESTORED. This corner was established midway between center of Section and North 1/4 corner.

Corner was placed and witnessed January 27, 1960 with H. S. Peterson, District Forester.

SURVEYORS SEAL

SIGNED Billy D. Buckler DATE 2/23/60
REGISTERED LAND SURVEYOR
Billy D. Buckler