

MICHIGAN  
DEPARTMENT OF CONSERVATION  
FORESTRY DIVISION

LAND CORNER RECORD

T. 40 NR. 28 W


Dickinson COUNTY

DESCRIPTION OF CORNER N.W. 1/8 corner for Section 24

DESCRIPTION OF CORNER MONUMENT 1" x 48" Iron Pipe

WITNESSES TO CORNER 5" Cedar (BT) S 44° W 11 Links

5" Cedar (BT) N 5° W 41 1/2 Links

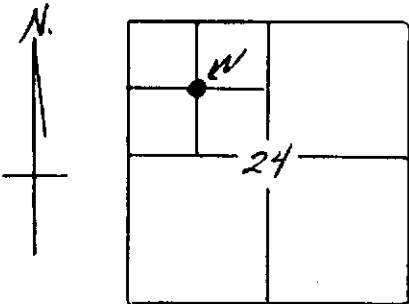

DESCRIPTION IN DETAIL AS TO HOW CORNER WAS LOCATED AND IDENTIFIED OR RESTORED. This corner was established at intersection of lines quartering the Northwest quarter section.

Corner was placed and witnessed January 27, 1960 with H. S. Peterson, District Forester.

SURVEYORS SEAL

SIGNED Billy D. Buckler DATE 2/23/60  
REGISTERED LAND SURVEYOR  
Billy D. Buckler