

MICHIGAN  
DEPARTMENT OF CONSERVATION  
FORESTRY DIVISION

LAND CORNER RECORD

T. 40. NR. 28. W.


D. i. o. k. i. n. s. o. n. COUNTY

DESCRIPTION OF CORNER East 1/8 corner for Section 24. -----

DESCRIPTION OF CORNER MONUMENT 1" x 48" Iron Pipe -----

WITNESSES TO CORNER 8" Cedar (BT) N 31° W 35 Links -----

9" Cedar (BT) S 83° E 40 Links -----

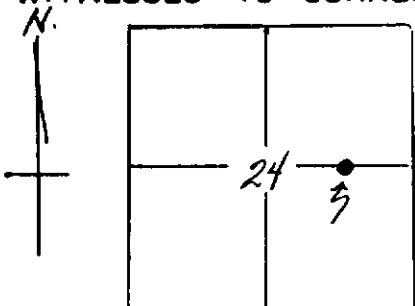

DESCRIPTION IN DETAIL AS TO HOW CORNER WAS LOCATED AND IDENTIFIED OR RESTORED. This corner was established midway between center of Section and East 1/4 corner.

Corner was placed and witnessed January 19, 1960 with Toivo Kauma, Assistant District Forester.

SURVEYORS SEAL

SIGNED

*Billy D. Buckler*  
REGISTERED LAND SURVEYOR  
Billy D. Buckler

DATE 2/23/60.