

MICHIGAN
DEPARTMENT OF CONSERVATION
FORESTRY DIVISION

LAND CORNER RECORD

T.40. NR.28. W


D i s k i n s o n COUNTY

DESCRIPTION OF CORNER N E 1/8 corner for section 24

DESCRIPTION OF CORNER MONUMENT 1" x 48" Iron Pipe

WITNESSES TO CORNER 9" Cedar (BT) N 25° W 19 1/2 Links

6" Cedar (BT) S 73° W 27 1/2 Links

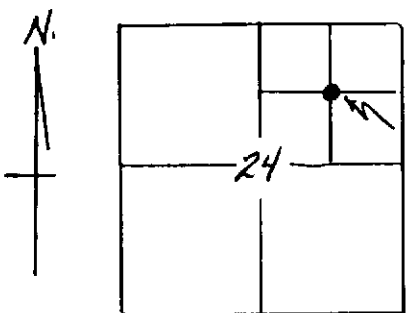

DESCRIPTION IN DETAIL AS TO HOW CORNER WAS LOCATED AND IDENTIFIED OR RESTORED. This corner was established at intersection of lines quartering the N E quarter Section.

Corner was placed and witnessed January 19, 1960 with Toivo Kauma, Assistant District Forester.

SURVEYORS SEAL

SIGNED Billy D. Buckler DATE 2/23/60
REGISTERED LAND SURVEYOR
Billy D. Buckler