

MICHIGAN
DEPARTMENT OF CONSERVATION
FORESTRY DIVISION

LAND CORNER RECORD


T. 40. NR. 28. W

Dickinson COUNTY

DESCRIPTION OF CORNER West 1/8 corner between 13 and 24

DESCRIPTION OF CORNER MONUMENT 1" x 48" Iron Pipe

WITNESSES TO CORNER 5" Cedar (BT) N 57° W 06 1/2 Links

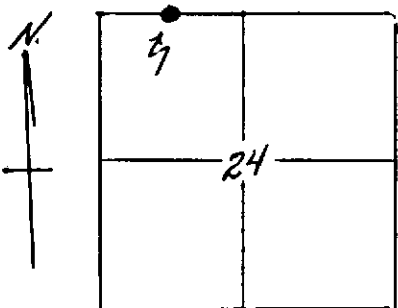

6" Cedar (BT) N 8° E 28 Links

4" Cedar (BT) S 40° E 15 Links

DESCRIPTION IN DETAIL AS TO HOW CORNER WAS LOCATED AND IDENTIFIED OR RESTORED. This corner was set midway between Section Corner to west and 1/4 corner to east.

Corner was placed and witnessed December 9, 1959 with Frank J. Bray, Engineer Aide I.

SURVEYORS SEAL

SIGNED Billy D. Buckler
REGISTERED LAND SURVEYOR
Billy D. Buckler

DATE 2/23/60