

DEC 18 1995

COMMISSION

LAND CORNER RECORDATION CERTIFICATE

Filing Requirement of Act 74, Mich. P.A. 1970

RECORDED

NOV 21 AM 11:27

For corners in
Dickinson
(County)

Located In:

Corner Code #

- | | | | |
|---|--------------|--------------|-------------|
| 1. Public Land Survey | T <u>40N</u> | R <u>29W</u> | <u>C-12</u> |
| | T _____ | R _____ | _____ |
| | T _____ | R _____ | _____ |
| | T _____ | R _____ | _____ |
| 2. Property Controlling
in Section | S _____ | T _____ | R _____ |
| | S _____ | T _____ | R _____ |
| 3. Miscellaneous
Property in Section | S _____ | T _____ | R _____ |
| | S _____ | T _____ | R _____ |

REGISTERED DEEDS
DICKINSON COUNTY

Register of Deeds Stamp & File Number

4. Lot No. _____, Recorded Plat _____
5. Private Claims _____

	A	B	C	D	E	F	G	H	I	J	K	L	M
2	6		5		4		3		2		1		
3													
4	7		8		9		10		11		12		
5													
6	18		17		16		15		14		13		
7													
8	19		20		21		22		23		24		
9													
10	30		29		28		27		26		25		
11													
12	31		32		33		34		35		36		
13													

I, Robert F. Perkins, in a field survey on Oct. 11, 1995
do hereby certify that under requirements of P.A. 74; Michigan P.A. of 1970, the corner points mentioned in lines 1 and 2 above were in conformance with regulations and rules therefore as required in the current manual of survey instructions of the United States Department of the Interior, Bureau of Land Management or by a decree of a Court of Law and/or that the corner points mentioned in lines 3, 4 and 5 above were in conformance with the rules of the Michigan Board of Professional Surveyors or by a Decree of a Court of Law; established, re-established, monumented, re-monumented, recovered, found as expressed below:

NOTE: Not more than 4 corners, all in the same town and range, may be recorded on this certificate.

A. Description of original monument and accessories and/or subsequent restoration:

C-12 East $\frac{1}{4}$ Corner, Section 31
Post J. Mullett, D.S. 1849
Original Bearing Trees
Cedar 10" S80°E 6 Lks.
Cedar 10" S35°W 13 Lks.


ACCEPTED BY THE DICKINSON COUNTY
SURVEY PEER GROUP AS THE OFFICIAL
CORNER UNDER MICHIGAN PUBLIC ACT
345 OF 1890 AT A MEETING HELD ON
11-20-95
RFP
COUNTY REPRESENTATIVE

B. Description of corner evidence found and/or method applied in restoring or reestablishing corner:

C-12 No Evidence of Original Corner or Accessories Found.
City of Norway Land Record indicates Concrete Monument
buried 17" in Road with Witnesses to Corners of Concrete Headwall
of Box Culvert.
S15°E 75.2'
S15°W 75.2'
Road has been Raised additional 3 feet.
Corner Researched in 1994.

C. Description of monument for corner and accessories established to perpetuate locating the position of the corner:

C-12 Set 2 $\frac{1}{2}$ " Stamped D.C. Remon. Monument in Monument Box from above noted Witnesses.
Corner falls 2.7' East of Road L at Old E-W Fence Line.
New Witnesses
Cedar 5" N71°E (M.B.) 50.39'
Cedar 4" S69°E (M.B.) 37.55'
Cedar 10" S85°W (M.B.) 72.90'
Power Pole #71-2419 N23°W (M.B.) 82.10'

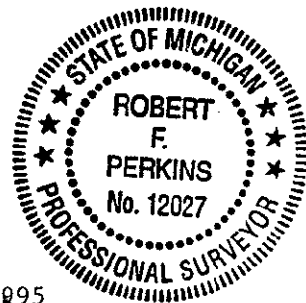

Signed by Robert F. Perkins

Date Nov. 7, 1995

Surveyor's Michigan License No. 12027