

LAND CORNER RECORDATION CERTIFICATE
Filing Requirement of Act 74, Mich. P.A. 1970

For corners in Dickinson <hr/> (County)	Located in:	Corner Code #
1. Public Land Survey	T 40N R 29W	F1
	T _____ R _____	_____
	T _____ R _____	_____
	T _____ R _____	_____
2. Property Controlling in Section	S 4 T 40N R 29W	13
	S _____ T _____ R _____	_____
3. Miscellaneous Property in Sec.	S _____ T _____ R _____	_____
	S _____ T _____ R _____	_____

Register of Deeds Stamp & File Number

4. Lot No. _____, Recorded Plat _____
5. Private Claims _____

13 Mar 12 2001
F1 Nov 28 2000

A	B	C	D	E	F	G	H	I	J	K	L	M
1					●							
2	6		5		4		3		2			1
3					●							
4	7		8		9		10		11			12
5												
6	18		17		16		15		14			13
7												
8	19		20		21		22		23			24
9												
10	30		29		28		27		26			25
11												
12	31		32		33		34		35			36
13												


I, Stephan J. Szyszkoski, in a field survey on _____, 19____ do hereby state that under requirements of P.A. 74, Michigan P.A. of 1970, the corner points mentioned in lines 1 and 2 above were in conformance with regulations and rules therefore as required in the current manual of survey instructions of the United States Department of the Interior, Bureau of Land Management or by a decree of a Court of Law and /or that the corner points mentioned in lines 3, 4 and 5 above were in conformance with the rules of the Michigan Board of Land Surveyors or by a Decree of a Court of Law; established, re-established, monumented, recovered, found as expressed below:

NOTE: Not more than 2 corners, all in the same town and range, may be recorded on this certificate.

A. Description of original monument and accessories and/or subsequent restoration:
(F1) North Quarter corner of Section 4. Not established in the original survey. Found no subsequent record.
(13-Sec. 4) Southeast 1/16 corner, Section 4. Corner not established in the original survey. Found no subsequent record.

B. Description of corner evidence found and/or method applied in restoring or reestablishing corner:
(F1) Established the corner on the 4th Correction Line, a line of mean true bearing between monumented adjacent standard corners J13 and K13 of T41N-R29W, and equidistant between closing corner monuments 2636.16' east and west.
(13-Sec. 4) Established the corner at the intersection of straight lines connecting opposite 1/16 corners.

C. Description of monument for corner and accessories established to perpetuate locating the position of the corner:
(F1) Set 1" ID pipe with 4" aluminum MDNR cap. Blazed and scribed: (13) Set 1" ID x 32" iron pipe with 4" aluminum MDNR cap in 3'x2.5'x2' high rock mound. Blazed and scribed:
8" Maple N82E 4.2' "1/4S BT" 7" Sugar S72E 19.4' "1/16S BT"
5" Sugar S63W 11.5' do 8" Sugar S07E 17.7' do
12" Oak S81W 44.6' do 8" Sugar S73W 38.6' do
5" Maple N14W 22.6' do 8" Sugar N45W 11.3' do
Sqd cedar post adjacent. Bearings are magnetic. Distances are to notch in lower blaze. Sqd cedar post adjacent. Bearings are magnetic. Distances are to notch in lower blaze.

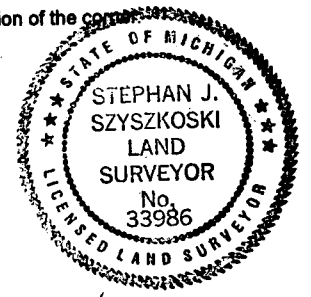

Signed by Stephan J. Szyszkoski Date 3/29/01
Surveyor's Michigan License No. 33986

For the Michigan Department of Natural Resources - Forest Management Division