

Common to:
 K-13 (M-13) T40-29
 (K-13) (T-13) A13 41-28

M-13/A-13 T41N-R28W

LAND CORNER RECORDATION CERTIFICATE
 Filing Requirement of Act 74, Mich. P.A. 1970

RECORDED
 1999 NOV 30 PM 3:31

For corners in

DICKINSON Located In: _____ Corner Code # _____
 (County)
 NORWAY TOWNSHIP

1. Public Land Survey T 41 N R 29 W K-13
 T 41 N R 29 W M-13
 T _____ R _____
 T _____ R _____
2. Property Controlling S _____ T _____ R _____
 In Section S _____ T _____ R _____
3. Miscellaneous S _____ T _____ R _____
 Property in Sec. S _____ T _____ R _____

**SURVEY &
 REMONUMENTATION**

REGISTER OF DEEDS
 DICKINSON COUNTY
 RON MOORE, CLERK

Register of Deeds Stamp & File Number

MAR 24 2000

4. Lot No. _____, Recorded Plat _____

5. Private Claims _____ SECTION _____

I, JAMES H. MOORE, in a field survey on SEPTEMBER 2, 19 99 do hereby state that under requirements of P.A. 74, Michigan P.A. of 1970, the corner points mentioned in lines 1 and 2 above were in conformance with regulations and rules therefore as required in the current manual of survey instructions of the United States Department of the Interior, Bureau of Land Management or by a decree of a Court of Law and /or that the corner points mentioned in lines 3, 4 and 5 above were in conformance with the rules of the Michigan Board of Land Surveyors or by a Decree of a Court of Law; established, re-established, monumented, recovered, found as expressed below:

	A	B	C	D	E	F	G	H	I	J	K	L	M
1													
2	6		5		4		3		2		1		
3													
4	7		8		9		10		11		12		
5													
6	18		17		16		15		14		13		
7													
8	19		20		21		22		23		24		
9													
10	30		29		28		27		26		25		
11													
12	31		32		33		34		35		36		
13													

NOTE: Not more than 2 corners, all in the same town and range, may be recorded on this certificate.

A. Description of original monument and accessories and/or subsequent restoration:

- K-13** CORNER COMMON TO SECTIONS 35-36, T41N-R29W
 CEDAR POST BY AUSTIN BURT, D.S. 1846
 PINE 14" N 50° E 16 LINKS
 CEDAR 7" N 20° W 27 LINKS
- M-13** CORNER COMMON TO SECTIONS 31-36, T41N-R28 & 29 W
 CEDAR POST BY AUSTIN BURT, D.S. 1846
 WHITE PINE 40" N 72° E 48 LINKS
 CEDAR 14" N 25° W 17 LINKS

B. Description of corner evidence found and/or method applied in restoring or reestablishing corner:


- K-13** FOUND 1" PIPE WITH 4" MICHIGAN DEPARTMENT OF CONSERVATION BRASS CAP, SET BY DEAN DE LA MATER R.L.S. #13030.
 1951 BEARING TREES
 10" CEDAR N 60° W 28 LINKS
 8" RED OAK S 49° W 46 LINKS
- M-13** FOUND 1" PIPE WITH 4" MICHIGAN DEPARTMENT OF CONSERVATION BRASS CAP, SET BY BILL BUCKLER R.L.S. #08887
 1956 BEARING TREES
 9" ASPEN N 58° W 9 LINKS
 7" BALSAM N 74° E 26 LINKS

C. Description of monument for corner and accessories established to perpetuate locating the position of the corner:

- K-13** FOUND ABOVE DESCRIBED MONUMENT IN PLACE
 NEW WITNESSES
 8" MAPLE N 63° E (M.B.) 17.10' NAIL/TAG
 6" MAPLE S 37° E (M.B.) 11.12' NAIL/TAG
 FOUND 16" RED OAK S 51° W (M.B.) 30.48' NAIL/TAG
 8" MAPLE N 69° W (M.B.) 43.65' NAIL/TAG
 CARSONITE MARKER SOUTH 0.80'
- M-13** FOUND ABOVE DESCRIBED MONUMENT IN PLACE
 NEW WITNESSES
 5" ASPEN N 20° E (M.B.) 16.64' NAIL/TAG
 5" ASPEN S 86° E (M.B.) 7.20' NAIL/TAG
 4" ASPEN S 25° W (M.B.) 12.18' NAIL/TAG
 5" ASPEN S 77° W (M.B.) 28.78' NAIL/TAG
 14" CEDAR N 59° W (M.B.) 56.39' NAIL/TAG
 CARSONITE MARKER N 15° W 0.70'

Signed by JAMES H. MOORE
 Surveyor's Michigan License No. P.S. 28423

Date 11-8-99

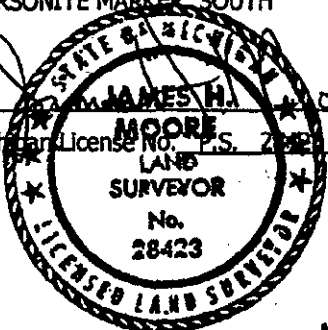

ORM APPROVED BY MICHIGAN STATE BOARD OF PROFESSIONAL SURVEYORS, JAN. 28, 1971

REVISED MAY 14, 1975
 REVISED JAN., 1983
 REVISED OCT., 1995

ACCEPTED BY THE DICKINSON COUNTY SURVEY PEER GROUP AS THE OFFICIAL CORNER UNDER MICHIGAN PUBLIC ACT 345 OF 1990 AT A MEETING HELD ON

11-23-99
[Signature]
 COUNTY REPRESENTATIVE

LIBER 3 PAGE 9