

LAND CORNER RECORDATION CERTIFICATE
Filing Requirement of Act 74, Mich. P.A. 1970

RECORDED
1998 JUN 12 AM 8:58

For corners in

<u>Dickinson</u>	Located In:	Corner Code #
(County) Breitung Township		
1. Public Land Survey	T <u>40N</u> R <u>R30W</u>	<u>D-1</u>
	T ___ R ___	_____
	T ___ R ___	_____
	T ___ R ___	_____
2. Property Controlling in Section	S ___ T ___ R ___	_____
	S ___ T ___ R ___	_____
3. Miscellaneous Property in Sec.	S ___ T ___ R ___	_____
	S ___ T ___ R ___	_____

REGISTER OF DEEDS
DICKINSON COUNTY
IRON MOUNTAIN, MI 49901

**SURVEY &
REMONUMENTATION**

APR 02 1999

Register of Deeds Stamp & File Number

4. Lot No. _____, Recorded Plat _____
5. Private Claims _____

I, Ewart C. Muller, in a field survey on May 20, 1998 do hereby state that under requirements of P.A. 74, Michigan P.A. of 1970, the corner points mentioned in lines 1 and 2 above were in conformance with regulations and rules therefore as required in the current manual of survey instructions of the United States Department of the Interior, Bureau of Land Management or by a decree of a Court of Law and/or that the corner points mentioned in lines 3, 4 and 5 above were in conformance with the rules of the Michigan Board of Land Surveyors or by a Decree of a Court of Law; established, re-established, monumented, recovered, found as expressed below:

NOTE: Not more than 2 corners, all in the same town and range, may be recorded on this certificate.

Wm Austin Burt ran 4th Correction Line in 1846
J.H. Mullet Subdivided Township in 1849

A	B	C	D	E	F	G	H	I	J	K	L	M
1												
2	6		5		4		3		2		1	
3												
4	7		8		9		10		11		12	
5												
6	10		17		16		15		14		13	
7												
8	19		20		21		22		23		24	
9												
10	30		29		28		27		26		25	
11												
12	31		32		33		34		35		36	
13												

A. Description of original monument and accessories and/or subsequent restoration:

D-1 Corner not set in Original Survey. No Subsequent corner found. Corner lies on North edge of a cleared Power Company Tower right-of-way

B. Description of corner evidence found and/or method applied in restoring or reestablishing corner:

D-1 Set 1/4 corner Midway on arc 2635.05 feet East of Dickinson County Monumented Closing Corner of Sections 5 & 6 and 2635.05 feet West of DNR Monumented Closing Corner of Sections 4 & 5

ACCEPTED BY THE DICKINSON COUNTY
SURVEY PEER GROUP AS THE OFFICIAL
CORNER UNDER MICHIGAN PUBLIC ACT
345 OF 1990 AT A MEETING HELD ON
6-4-98
REP
COUNTY REPRESENTATIVE


C. Description of monument for corner and accessories established to perpetuate locating the position of the corner:

D-1 Set Aluminum Rod with 3/4-inch Dickinson County Aluminum Cap Stamped N 1/4 S5, T40N,R30W and T41N,R30W above

Witnesses: Triple Red Maple 10, N4W 16.60; Red Maple 9 N76E 27.35; Double Red Oak 10 S10E 99.25;
Red Oak 6 S40E 127.22.

All Bearings Magnetic. Measurements to a nail in sides of trees.

Signed by Ewart C Muller
Surveyor's Michigan License No. 15408

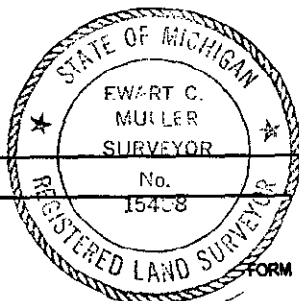

Date June 3, 1998