

SURVEY & REMONUMENTATION

MAR 03 1998

LAND CORNER RECORDATION CERTIFICATE
 Filing Requirement of Act 74, Mich. P.A. 1970

RECORDED

1997 NOV 13 AM 9:31

For corners in **SECTION**

<u>Dickinson</u>	Located In:	Corner Code #
(County) Breitung Twp		
1. Public Land Survey	T <u>40N</u> R <u>30W</u>	<u>J-13</u>
	T <u>40N</u> R <u>30W</u>	<u>K-13</u>
	T _____ R _____	_____
	T _____ R _____	_____
2. Property Controlling in Section	S _____ T _____ R _____	_____
	S _____ T _____ R _____	_____
3. Miscellaneous Property in Sec.	S _____ T _____ R _____	_____
	S _____ T _____ R _____	_____

REGISTER OF DEEDS
 DICKINSON COUNTY
 IRON MOUNTAIN, MICHIGAN 49801

Register of Deeds Stamp & File Number

4. Lot No. _____, Recorded Plat _____
 5. Private Claims _____

I, Ewart C. Muller, in a field survey on September 10 19 97 do hereby state that under requirements of P.A. 74, Michigan P.A. of 1970, the corner points mentioned in lines 1 and 2 above were in conformance with regulations and rules therefore as required in the current manual of survey instructions of the United States Department of the Interior, Bureau of Land Management or by a decree of a Court of Law and /or that the corner points mentioned in lines 3, 4 and 5 above were in conformance with the rules of the Michigan Board of Land Surveyors or by a Decree of a Court of Law; established, re-established, monumented, recovered, found as expressed below:

NOTE: Not more than 2 corners, all in the same town and range, may be recorded on this certificate.

Surveyed by James Mullet, D.S. 1849

A. Description of original monument and accessories and/or subsequent restoration:

- J-13 Set quarter section post on summit.
BT's: Maple 4 N46E 22 lks; Birch 10 N41W 27 lks
- K-13 Set post corner Sections 35 & 36
BT's: Maple 4 N17E 25 lks; Maple 5 N26W 27 lks

ACCEPTED BY THE DICKINSON COUNTY SURVEY PEER GROUP AS THE OFFICIAL CORNER UNDER MICHIGAN PUBLIC ACT 345 OF 1990 AT A MEETING HELD ON 11-12-97
R.O.P.
 COUNTY REPRESENTATIVE

B. Description of corner evidence found and/or method applied in restoring or reestablishing corner:


- J-13 Found 2½" iron pipe with brass cap set by Wisc-Mich Power Co. Ed Kazianka witnessed it in 1980.(Corner report #246). some witnesses destroyed.
NBT's: Oak 6 N22W 25.20; Oak 10 S39W 29.05; Maple 5 S80W 45.50
- K-13 Found conc. mon. Ed Kazianka replaced iron pipe at fence corner with conc. mon. in 1980. See corner report #246.
NBT's: Oak 9 N6W 52.60(found); Oak 19 N12E 53.16; Oak 15 S36E 34.70(found).

C. Description of monument for corner and accessories established to perpetuate locating the position of the corner:

- J-13 Re-witnessed 2½" iron pipe with brass cap.
NBT's: Oak 13 N18W 25.77; W.Birch 8 S77W 12.05; Oak 15 S21W 45.38; R.Maple East 106.77
Set carsonite stake by corner. Corner lies near west edge of power line r/w.
- K-13 Re-witnessed conc mon. at fence intersection
NBT's: Oak 10 N4W 52.60; R.Maple clump 8 N48E 42.20; R.Maple clump 12 S76E51.87;
Oak 21 S26E 34.70
Set carsonite stake by corner.
Note: Measurements to nails in side of trees. Bearings are magnetic.

Signed by Ewart C. Muller
 Surveyor's Michigan License No. 15408

Date November 4, 1997

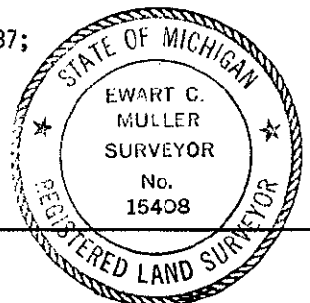

Lines 2 Page 305