SURVEY & REMONUMENTATION

MAR 0 3 1998

SECTION

LAND CORNER RECORDATION CERTIFICATE

Filing Requirement of Act 74, Mich. P.A. 1970

RECORDED

1997 DEC 10 PM 3:54

REGISTER OF DEEDS
DICKINSON COUNTY
RON MOUR[illegible]

Register of Deeds Stamp & File Number

For corners in Dickinson (County)
Breitung Twp.

Located In: Corner Code #

1. Public Land Survey — T 40N R 30W — K-12; T ___ R ___ — L-11; T ___ R ___; T ___ R ___
2. Property Controlling in Section — S ___ T ___ R ___; S ___ T ___ R ___
3. Miscellaneous Property in Section — S ___ T ___ R ___; S ___ T ___ R ___
4. Lot No. _____, Recorded Plat _____
5. Private Claims _____

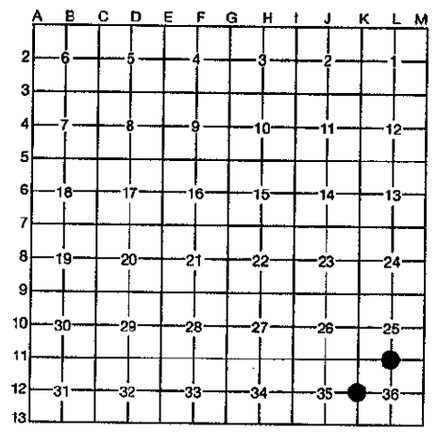

I, Robert F. Perkins, in a field survey on Oct. 9, 19 97, do hereby certify that under requirements of P.A. 74, Michigan P.A. of 1970, the corner points mentioned in lines 1 and 2 above were in conformance with regulations and rules therefore as required in the current manual of survey instructions of the United States Department of the Interior, Bureau of Land Management or by a decree of a Court of Law and/or that the corner points mentioned in lines 3, 4 and 5 above were in conformance with the rules of the Michigan Board of Professional Surveyors or by a Decree of a Court of Law; established, re-established, monumented, re-monumented, recovered, found as expressed below:

NOTE: Not more than 4 corners, all in the same town and range, may be recorded on this certificate.

A. Description of original monument and accessories and/or subsequent restoration:

K-12 ¼ Corner Common to Sections 35/36
Post by James H. Mullett, D.S. 1849
Original Bearing Trees
Sugar 10" S70°E 13 Lks.
Birch 10" N12°W 14 Lks.

L-11 ¼ Corner Common to Sections 25/36
Post by J.H. Mullett, D.S. 1849
Original Bearing Trees
Hemlock 12" N40°E(M.B.) 21 Lks.
Lynn 8" S60°W(M.B.) 20 Lks.

ACCEPTED BY THE DICKINSON COUNTY SURVEY PEER GROUP AS THE OFFICIAL CORNER UNDER MICHIGAN PUBLIC ACT 345 OF 1990 AT A MEETING HELD ON
12-9-97
RDP.
COUNTY REPRESENTATIVE

B. Description of corner evidence found and/or method applied in restoring or reestablishing corner:

K-12 No Evidence of Original Corner or Accessories Found.
Found 1¼" Solid Iron Bar in North-South Fence with Remains of Obliterated Fence West.
Iron Bar is identical to type set by Penn Iron Co. around 1900.
Location agrees with G.L.O. Calls to Swamp and Creek North.
Corner Researched in 1996 Remon. Program.

L-11 No Evidence of Original Corner or accessories Found.
Found 5/8" Iron Bar at Old Fence Corner and 4 newer B.T.'s.
Distance West along old Fence to Centerline RR Grade checks with 1892 E.I.M.& W. RR Map (413' Map-415'Meas.)

C. Description of monument for corner and accessories established to perpetuate locating the position of the corner:

K-12 Accepted above Described Iron Bar as Best Available Evidence of Corner Location. Set 3½" Stamped D.C.Remon. Corner at Ex. Iron Rod.
New Witnesses:
Oak 7" S43°W(M.B.) 24.05' Nail/Tag
Oak 12" N24°E(M.B.) 16.68' Nail/Tag
Maple 6" S05°E(M.B.) 22.52' Nail/Tag
R.Pine 5" N40°W(M.B.) 36.68' Nail/Tag
Carsonite Stake North 0.5'

L-11 Accepted above described Location as Best Available Evidence of Corner Location.
Replaced Iron Bar with 2½" Stamped D.C. Remon. Corner.
New Witnesses:
Aspen 14" N60°W(M.B.) 13.62' Nail/Tag
Aspen 6" S35°W(M.B.) 8.67' " "
Lynn 12" S30°E(M.B.) 41.48" " "
Lynn 8" S45°E(M.B.) 14.21' " "
Carsonite Marker South 0.5'

Signed by [signature] Date Nov. 26, 1997

Surveyor's Michigan License No. 12027

STATE OF MICHIGAN ROBERT F. PERKINS No. 12027 PROFESSIONAL SURVEYOR

FORM APPROVED BY MICHIGAN STATE BOARD OF PROFESSIONAL SURVEYORS, JAN. 28, 1971
REVISED MAY 14, 1975
REVISED JAN., 1983

LIBER 002 PAGE 335