

SURVEY & REMONUMENTATION

MAR 03 1998

RECORDED

1997 DEC 10 PM 3:54

SECTION

LAND CORNER RECORDATION CERTIFICATE
Filing Requirement of Act 74, Mich. P.A. 1970

For corners in

Dickinson
(County)

Located in:

Corner Code #

Breitung Twp.

1. Public Land Survey	T	<u>40N</u>	R	<u>30W</u>	<u>M.C. 26/27</u>
	T		R		<u>S. of I-9</u>
	T		R		<u>#001</u>
	T		R		<u>M.C. 26/27</u>
2. Property Controlling in Section	S		T	R	<u>N. of I-11</u>
	S		T	R	<u>Other #</u>
	S		T	R	<u>#006</u>
3. Miscellaneous Property in Section	S		T	R	
	S		T	R	

REGISTER OF DEEDS
DICKINSON COUNTY
RON NOBLE, COUNTY CLERK

Register of Deeds Stamp & File Number

4. Lot No. _____, Recorded Plat _____
5. Private Claims _____

I, Robert F. Perkins, in a field survey on Oct. 29, 1997, do hereby certify that under requirements of P.A. 74, Michigan P.A. of 1970, the corner points mentioned in lines 1 and 2 above were in conformance with regulations and rules therefore as required in the current manual of survey instructions of the United States Department of the Interior, Bureau of Land Management or by a decree of a Court of Law and/or that the corner points mentioned in lines 3, 4 and 5 above were in conformance with the rules of the Michigan Board of Professional Surveyors or by a Decree of a Court of Law; established, re-established, monumented, re-monumented, recovered, found as expressed below:

A	B	C	D	E	F	G	H	I	J	K	L	M
2	6	5	4	3	2	1						
3												
4	7	8	9	10	11	12						
5												
6	18	17	16	15	14	13						
7												
8	19	20	21	22	23	24						
9												
10	30	29	28	27	26	25						
11												
12	31	32	33	34	35	36						
13												

NOTE: Not more than 4 corners, all in the same town and range, may be recorded on this certificate.

A. Description of original monument and accessories and/or subsequent restoration:

NORTH MEANDER CORNER 27/26
Post by James H. Mullett, D.S. 1849
Original Bearing Trees
Tamarack 10" N41°W 52 Lks.
Tamarack 6" N36°E 31 Lks.
V110°W

SOUTH MEANDER CORNER 27/26
Post by James H. Mullett, D.S. 1849
Original Bearing Trees
Birch 8" S1/2°E 06 Lks.
Birch 8" N89°W 100 Lks

RECORDED BY THE DICKINSON COUNTY SURVEY PEER GROUP AS THE OFFICIAL CORNER UNDER MICHIGAN PUBLIC ACT 345 OF 1990 AT A MEETING HELD ON 12-9-97

COUNTY REPRESENTATIVE

B. Description of corner evidence found and/or method applied in restoring or reestablishing corner:

N-M.C. 27/26
No Evidence of Original Corner or Accessories Found.
Lake Level appears to have been raised subsequent to Original Survey. G.L.O. Notes place M.C. 1815' South of Section Corner. Present Lake is ± 1600' South. Found Iron Pipe (N.1/16) Corner at old Fence Corner 1406.57' South of Section Corner. Fence continues South to Water.

S-M.C. 27/26
No Evidence of Original Corner or Accessories Found.
Lake Level appears to have been raised subsequent to Original Survey. G.L.O. Calls along this do not appear reliable.


C. Description of monument for corner and accessories established to perpetuate locating the position of the corner:

N-M.C. 27/26
Set 2 1/2" Stamped D.C. Remon. Corner in Line with 1/16 Corner and Section Corner to North (± 1.5' East of Old Fence).
New Witnesses:
Spruce 6" S88°E (M.B.) 15.90' Nail/Tag
Fir 3" N47°E (M.B.) 44.07' Nail/Tag
Cedar 16" S85°E (M.B.) 40.92' Nail/Tag
Aspen 8" N30°E (M.B.) 32.32' Nail/Tag

S-M.C. 27/26
Set 2 1/2" Stamped D.C. Remon. Corner at Lake Shore 890.95' Due North of Section Corner 26-27-34-35.
New Witnesses:
Cedar 8" S50°W(M.B.) 85.4' Nail/Tag
Fir 5" S87°W(M.B.) 95.25' Nail/Tag
Dbl. 4" Maple S46°E(M.B.) 33.00' Nail/Tag
X on 4' Boulder S62°W(M.B.) 13.00'
± 20' South to Centerline Steel Tower Line.

Signed by Robert F. Perkins Date Nov. 26, 1997

Surveyor's Michigan License No. 12027

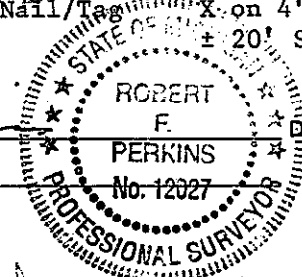

FORM APPROVED BY MICHIGAN STATE BOARD OF PROFESSIONAL SURVEYORS, JAN. 28, 1971
REVISED MAY 14, 1975
REVISED JAN., 1983

LIBER 002 PAGE 337