SURVEY & REMONUMENTATION

MAY 07 1997

COMMISSION

RECORDED

1996 DEC 18 AM 11: 17

LAND CORNER RECORDATION CERTIFICATE

Filing Requirement of Act 74, Mich. P.A. 1970

For corners in
DICKINSON (County)

Located In:
WAUCEDAH TWP.

REGISTER OF DEEDS
DICKINSON COUNTY
IRON MOUNTAIN, MI 49801

27

Register of Deeds Stamp & File Number

			Corner Code #
1. Public Land Survey		T 41N R 27W	F-13
		T ___ R ___	E-13
		T ___ R ___	
		T ___ R ___	
2. Property Controlling	S ___	T ___ R ___	
in Section	S ___	T ___ R ___	
3. Miscellaneous	S ___	T ___ R ___	
Property in Section	S ___	T ___ R ___	

4. Lot No. _____, Recorded Plat _____
5. Private Claims _____

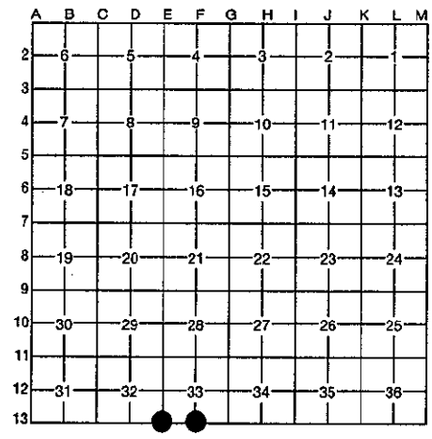

I, ROBERT F. PERKINS, in a field survey on 10-15, 19 96, do hereby certify that under requirements of P.A. 74, Michigan P.A. of 1970, the corner points mentioned in lines 1 and 2 above were in conformance with regulations and rules therefore as required in the current manual of survey instructions of the United States Department of the Interior, Bureau of Land Management or by a decree of a Court of Law and/or that the corner points mentioned in lines 3, 4 and 5 above were in conformance with the rules of the Michigan Board of Professional Surveyors or by a Decree of a Court of Law; established, re-established, monumented, re-monumented, recovered, found as expressed below:

NOTE: Not more than 4 corners, all in the same town and range, may be recorded on this certificate.

A. Description of original monument and accessories and/or subsequent restoration:

F-13 SOUTH ¼ CORNER SECTION 33
POST BY AUSTIN BURT, D.S. 1846
ORIGINAL BEARING TREES
SUGAR 6" N24°E 18 L.
SUGAR 6" N21½°W 20 L.

E-13 STANDARD CORNER BETWEEN SECTIONS 32 & 33
POST BY AUSTIN BURT, D.S. 1846
ORIGINAL BEARING TREES
CEDAR 12" N11°E 10 L. (FOUND STUMP)
CEDAR 12" N38°W 24 L.

B. Description of corner evidence found and/or method applied in restoring or reestablishing corner:

F-13 NO EVIDENCE OF ORIGINAL CORNER OR ACCESSORIES FOUND. CORNER ESTABLISHED ON A STRAIGHT LINE CONNECTING STANDARD SECTION CORNERS 2646.51' EAST AND 2636.51' WEST.

E-13 FOUND 16" CEDAR STUMP WITH LOWER BLAZE, FITS FOR GOV'T. B.T. "CEDAR 12" N11°E 10 L." ALSO CORNER OF ANCIENT FENCE LINE NORTH AND WEST & OLD ROAD RUNNING NORTH AND WEST.

ACCEPTED BY THE DICKINSON COUNTY SURVEY PEER GROUP AS THE OFFICIAL CORNER UNDER MICHIGAN PUBLIC ACT 345 OF 1990 AT A MEETING HELD ON
12-17-96
RDP
COUNTY REPRESENTATIVE

C. Description of monument for corner and accessories established to perpetuate locating the position of the corner:

F-13 SET 2½" STAMPED D.C. REMON. MONUMENT AT ABOVE LOCATION.
NEW BEARING TREES:
FIR 4" N60°E (M.B.) 9.94' CENTERLINE
FIR 3" N82°E (M.B.) 10.08' CENTERLINE
W. PINE 2" S12°W (M.B.) 14.19' CENTERLINE
ASPEN 5" S65°W (M.B.) 13.24' NAIL/TAG
EX. 1" IRON PIPE (NEW) S53°°W (M.B.) 28.16'
PLACED CARSONITE STAKE 1.0' NORTH OF CORNER.

E-13 SET 3½" STAMPED D.C. REMON. CAP ON 6' ROD FROM B.T. STUMP DESCRIBED ABOVE.
NEW BEARING TREES:
CEDAR 8" N15°E (M.B.) 11.90' NAIL/TAG
CEDAR 8" N75°E (M.B.) 21.83' NAIL/TAG
CEDAR 6" S05°E (M.B.) 34.34' NAIL/TAG
TAMARACK 12" S78°W (M.B.) 49.85' NAIL/TAG
CORNER FENCE POST N45°W (M.B.) ± 1'
PLACED CARSONITE MARKER 4.0' WEST OF CORNER.

STATE OF MICHIGAN
ROBERT F. PERKINS
No. 12027
PROFESSIONAL SURVEYOR

Signed by Robert F. Perkins Date NOVEMBER 6, 1996

Surveyor's Michigan License No. 12027

FORM APPROVED BY MICHIGAN STATE BOARD OF PROFESSIONAL SURVEYORS JAN. 29, 1987
REVISED MAY 14, 1975
REVISED JAN. 1, 1987

Liber 2 Page 271