

SURVEY & REMONUMENTATION

NOV 15 1999

RECORDED

1994 JUN -8 PM 2:47

LAND CORNER RECORDATION CERTIFICATE
Filing Requirement of Act 74, Mich. P.A. 1970

SECTION

For corners in

Dickinson (County)	Located In:	Corner Code #
1. Public Land Survey Sec. 2	T <u>41N</u> R <u>27W</u>	<u>I-2</u>
	T _____ R _____	_____
	T _____ R _____	_____
	T _____ R _____	_____
2. Property Controlling in Section	S _____ T _____ R _____	_____
	S _____ T _____ R _____	_____
3. Miscellaneous Property in Sec.	S _____ T _____ R _____	_____
	S _____ T _____ R _____	_____

ACCEPTED BY THE DICKINSON COUNTY SURVEY PEER GROUP AS THE OFFICIAL CORNER UNDER MICHIGAN PUBLIC ACT 345 OF 1990 AT A MEETING HELD ON 6-7-94
R.P.P.
COUNTY REPRESENTATIVE

Register of Deeds Stamp & File Number

4. Lot No. _____, Recorded Plat _____
5. Private Claims _____

West one-quarter corner of Section 2, T41N, R27W

I, John R. Garske, in a field survey on April, 19 94, do hereby certify that under requirements of P.A. 74, Michigan P.A. of 1970, the corner points mentioned in lines 1 and 2 above were in conformance with regulations and rules therefore as required in the current manual of survey instructions of the United States Department of the Interior, Bureau of Land Management or by a decree of a Court of Law and/or that the corner points mentioned in lines 3, 4 and 5 above were in conformance with the rules of the Michigan Board of Land Surveyors or by a Decree of a Court of Law; established, re-established, monumented, re-monumented, recovered, found as expressed below:

NOTE: Not more than 4 corners, all in the same town and range, may be recorded on this certificate.

	A	B	C	D	E	F	G	H	I	J	K	L	M
2	6	5	4	3	2	1							
3													
4	7	8	9	10	11	12							
5													
6	18	17	16	15	14	13							
7													
8	19	20	21	22	23	24							
9													
10	30	29	28	27	26	25							
11													
12	31	32	33	34	35	36							
13													

A. Description of original monument and accessories and/or subsequent restoration:

- 1850- Township subdivision by MM Hall, Surveyor for John Burt, D.S.; South corrected 41.70 ch. Cedar 10 quarter section post.
Hemlock 30 - N50°E, 11 links
- 1936- W.C. Johnson, Dickinson County Road Commission Surveyor: His field notes indicate an iron pin in centerline of road 2777.8 feet south of NW corner of Sec. 2

B. Description of corner evidence found and/or method applied in restoring or reestablishing corner:

No evidence of original corner or accessories remain.


I found a one-half inch iron pin in centerline of road 8" below surface of blacktop and a bent 2" pipe 37.5 feet ± west of iron pin. I accepted iron pin as marking the corner position after checking distances north and south.

C. Description of monument for corner and accessories established to perpetuate locating the position of the corner:

- I set a R.R. spike above existing iron pin and below surface of blacktop and established the following references:
- Ref. mon (A stamped Dick. Co. Monument .5 feet east of existing 2" pipe) - West 37.00 feet
 - Ref. mon. (A stamped Dick. Co. Monument set on line w/corner and previous ref. mon.) East 33.00 feet
 - Sugar 4" - S35°E, 49.26 feet
 - Spruce 8" - N25°W, 101.27 feet

Signed by John R. Garske
Surveyor's Michigan License No. 28410

Date 5/2/94

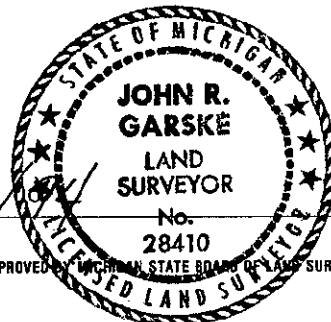

Label 2 pages