

# SURVEY & REMONUMENTATION

APR 27 1995

## LAND CORNER RECORDATION CERTIFICATE Filing Requirement of Act 74, Mich. P.A. 1970

RECORDED

JUN -8 PM 2:47

For corners in DICKINSON TOWNSHIP

Dickinson <small>(County)</small>	Located In:	Corner Code #/
1. Public Land Survey Sec. 2	T <u>41N</u> R <u>27W</u>	<u>K-1</u>
	T _____ R _____	_____
	T _____ R _____	_____
	T _____ R _____	_____
2. Property Controlling in Section	S _____ T _____ R _____	_____
	S _____ T _____ R _____	_____
3. Miscellaneous Property in Sec.	S _____ T _____ R _____	_____
	S _____ T _____ R _____	_____

ACCEPTED BY THE DICKINSON COUNTY  
SURVEY PEER GROUP AS THE OFFICIAL  
CORNER UNDER MICHIGAN PUBLIC ACT  
345 OF 1990 AT A MEETING HELD ON  
6-7-94  
RLP

COUNTY REPRESENTATIVE

Register of Deeds Stamp & File Number

4. Lot No. \_\_\_\_\_, Recorded Plat \_\_\_\_\_  
5. Private Claims \_\_\_\_\_

Northeast corner of Section 2, T41N, R27W

I, John R. Garske, in a field survey on April, 19 94, do hereby certify that under requirements of P.A. 74, Michigan P.A. of 1970, the corner points mentioned in lines 1 and 2 above were in conformance with regulations and rules therefore as required in the current manual of survey instructions of the United States Department of the Interior, Bureau of Land Management or by a decree of a Court of Law and/or that the corner points mentioned in lines 3, 4 and 5 above were in conformance with the rules of the Michigan Board of Land Surveyors or by a Decree of a Court of Law; established, re-established, monumented, re-monumented, recovered, found as expressed below:

**NOTE: Not more than 4 corners, all in the same town and range, may be recorded on this certificate.**

	A	B	C	D	E	F	G	H	I	J	K	L	M
2	6	5	4	3	2	1							
3													
4	7	8	9	10	11	12							
5													
6	10	17	16	15	14	13							
7													
8	19	20	21	22	23	24							
9													
10	30	29	28	27	26	25							
11													
12	31	32	33	34	35	36							
13													

**A. Description of original monument and accessories and/or subsequent restoration:**

- 1846- Township boundary by Austin Burt: West 80.00 ch. set cedar post. Cedar 14 - N62°E, 27 links; Sugar 18 - N78°W, 27 links.
- 1850- Township subdivision by MM Hall, Surveyor for John Burt, D.S. North 81.75 ch. intersect north boundary 90 links west of post. Y. birch 30 - S73°W, 63 links; Y. birch 30 - S43°E, 13 links.
- 1978- Robert F. Perkins, RLS #12027. Found a 1" pipe buried 12" in road. Balsam 3" - S19°E, 52.0 feet; Balsam 10" - N44°W, 88.0 feet; P. Pole - North 34.7 feet.

**B. Description of corner evidence found and/or method applied in restoring or reestablishing corner:**


No evidence of original corner or accessories remain.

I found a 1" iron pin 10" below surface of gravel road in road centerline as indicated by Robert Perkins, RLS, in 1978 survey, and accepted pipe as corner. Distance to N 1/4 corner of Section 1 as calculated checks with the 1978 survey.

**C. Description of monument for corner and accessories established to perpetuate locating the position of the corner:**

I set a Dickinson County monument consisting of a 3/4" x 36" aluminum rod and a 2 1/2" stamped aluminum cap set 6" below surface of gravel road and established the following references:

- Ref. mon (A stamped Dick. Co. Monument) - S39°E, 50.00 feet
- Red pine 12" - S76°W, 105.72 feet
- Wood post for telephone pedestal - N43°W, 44.13 feet
- Power Pole #74-2972 - North 34.62 feet

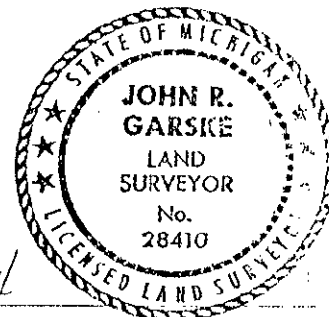

Signed by John R. Garske Date 5/2/94  
Surveyor's Michigan License No. 28410

Suber 2 Page 77