

M-8/A-8 T41N, R28W
 M-12/A-12 T41N, R28W

LAND CORNER RECORDATION CERTIFICATE
 Filing Requirement of Act 74, Mich. P.A. 1970

RECORDED
 1999 NOV 30 PM 3:31

For corners in

DICKINSON Located In: _____ Corner Code # _____
 (County)
 NORWAY TOWNSHIP

1. Public Land Survey T 41 N R 29 W M-8 _____
 T 41 N R 29 W M-12 _____
 T _____ R _____
 T _____ R _____
2. Property Controlling S _____ T _____ R _____
 in Section S _____ T _____ R _____
3. Miscellaneous S _____ T _____ R _____ SURVEY &
 Property in Sec. S _____ T _____ R _____ REMONUMENTATION

REGISTER OF DEEDS
 DICKINSON COUNTY
 1000 MORRIS BLVD. 49801

Register of Deeds Stamp & File Number

MAR 24 2000

4. Lot No. _____, Recorded Plat _____
 SECTION _____

I, JAMES H. MOORE, in a field survey on SEPTEMBER 1 & 2, 19 99 do hereby state that under requirements of P.A. 74, Michigan P.A. of 1970, the corner points mentioned in lines 1 and 2 above were in conformance with regulations and rules therefore as required in the current manual of survey instructions of the United States Department of the Interior, Bureau of Land Management or by a decree of a Court of Law and /or that the corner points mentioned in lines 3, 4 and 5 above were in conformance with the rules of the Michigan Board of Land Surveyors or by a Decree of a Court of Law; established, re-established, monumented, recovered, found as expressed below:

	A	B	C	D	E	F	G	H	I	J	K	L	M
1													
2	6		5		4		3		2		1		
3													
4	7		8		9		10		11		12		
5													
6	18		17		16		15		14		13		
7													
8	19		20		21		22		23		24		
9													
10	30		29		28		27		26		25		
11													
12	31		32		33		34		35		36		
13													

NOTE: Not more than 2 corners, all in the same town and range, may be recorded on this certificate.

A. Description of original monument and accessories and/or subsequent restoration:

- M-8 EAST 1/4 CORNER SECTION 24, T41N R29W/ WEST 1/4 CORNER SECTION 19, T41N R28W.
 CEDAR POST BY AUSTIN BURT, D.S. 1846
 FIR 7" S 70° W 38 LINKS
 PINE 18" N 25° E 45 LINKS
- M-12 EAST 1/4 CORNER SECTION 36, T41N R29W, WEST 1/4 CORNER SECTION 31, T41N R28W.
 CEDAR 6" BY AUSTIN BURT, D.S. 1846
 CEDAR 6" S 30° W 12 LINKS


B. Description of corner evidence found and/or method applied in restoring or reestablishing corner:

- M-8 FOUND 1" PIPE WITH 3-3/4" ALUMINUM CAP. SET BY AURTHUR O. ENGER R.L.S. #13581, DATED 11-8-77.
 1977 BEARING TREES
 12" WHITE SPRUCE S 54° E 21.9 FEET
 6" RED MAPLE N 1/2° E 20.7 FEET
- M-12 FOUND 1" PIPE WITH A 4" MICHIGAN DEPARTMENT OF CONSERVATION BRASS CAP, SET BY DEAN DE LA MATER R.L.S. #13030.
 1954 BEARING TREES
 14" CEDAR N 76° W 48 LINKS
 16" WHITE PINE N 04° E 64 LINKS

C. Description of monument for corner and accessories established to perpetuate locating the position of the corner:

- M-8 FOUND EXISTING ABOVE DESCRIBED MONUMENT IN PLACE
 NEW WITNESSES
 11" SPRUCE S 45° W (M.B.) 49.85' NAIL/TAG
 12" SPRUCE N 61° E (M.B.) 32.83' NAIL/TAG
 FOUND 9" MAPLE N 02° E (M.B.) 20.85' NAIL/TAG
 FOUND 12" SPRUCE S 53° E (M.B.) 22.37' NAIL/TAG
 CARSONITE MARKER 1.00'
- M-12 FOUND ABOVE DESCRIBED MONUMENT IN PLACE
 NEW WITNESSES
 9" ASH N 02° W (M.B.) 44.20' NAIL/TAG
 FOUND 18" WHITE PINE N 08° E (M.B.) 43.38' NAIL/TAG
 FOUND 14" CEDAR N 70° W (M.B.) 31.58' NAIL/TAG
 14" CEDAR S 08° W (M.B.) 44.15' NAIL/TAG
 10" CEDAR S 46° E (M.B.) 46.96' NAIL/TAG
 CARSONITE MARKER NORTH 0.30'

Signed by JAMES H. MOORE Date 11-8-99
 Surveyor's Michigan License No. 28423

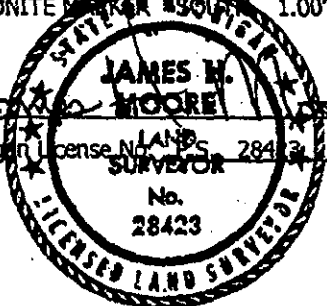

ACCEPTED BY THE DICKINSON COUNTY SURVEY BOARD AS THE OFFICIAL PROFESSIONAL SURVEYORS, JAN. 28, 1971
 FORM APPROVED BY MICHIGAN STATE BOARD OF PROFESSIONAL SURVEYORS, JAN. 28, 1971
 REVISED MAY 14, 1975
 REVISED JAN., 1983
 REVISED OCT., 1995

11-23-99
Robert A. P...
 COUNTY REPRESENTATIVE