

✓

MICHIGAN
DEPARTMENT OF CONSERVATION
FORESTRY DIVISION

LAND CORNER RECORD

T. 41. NR. 28 W.
Section 33

----- Dickinson ----- COUNTY


DESCRIPTION OF CORNER Center of section -----

DESCRIPTION OF CORNER MONUMENT 1" x 48" iron pipe -----

WITNESSES TO CORNER 4" E. Spruce S 3° E 38 links -----

3" W. Pine N 5° E 55½ links -----

scribed "C S 33" B.T.
scribed "X"

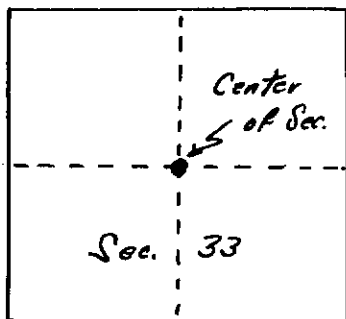

DESCRIPTION IN DETAIL AS TO HOW CORNER WAS LOCATED AND IDENTIFIED OR RESTORED.

Placed center of section 33 at intersection of E-W and N-S 1/4 lines.

SURVEYORS SEAL

SIGNED Billy D. Buckler DATE 1/13/58
REGISTERED LAND SURVEYOR