

MICHIGAN
DEPARTMENT OF CONSERVATION
FORESTRY DIVISION

LAND CORNER RECORD

T. 41 NR 28 W


Dickinson COUNTY

DESCRIPTION OF CORNER East 1/8 corner between Sec.'s 28-33

DESCRIPTION OF CORNER MONUMENT 1" x 48" iron pipe

WITNESSES TO CORNER 6" B. Spruce S 14° W 74 links
"BT"

6" B. Spruce N 14° W 91 links
"BT"

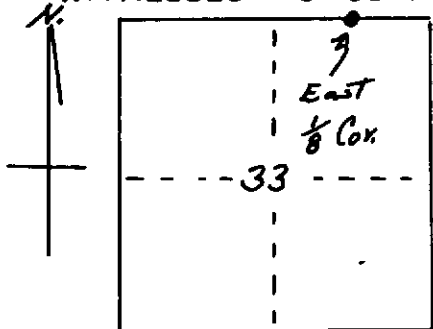

DESCRIPTION IN DETAIL AS TO HOW CORNER WAS LOCATED AND IDENTIFIED OR RESTORED.

Established 1/8 corner midway and on line between 1/4 corner between Sec.'s 28-33 and section corner common to 27-28-33-34.

SURVEYORS SEAL

SIGNED Billy D. Buckler DATE 1/13/58
REGISTERED LAND SURVEYOR