

MICHIGAN
DEPARTMENT OF CONSERVATION
FORESTRY DIVISION

LAND CORNER RECORD

T. 41. NR. 28 W.


Dickinson COUNTY

DESCRIPTION OF CORNER North 1/8 corner between Sec.'s 32-33

DESCRIPTION OF CORNER MONUMENT 1" x 48" iron pipe

WITNESSES TO CORNER 6" dead Tamarack stub S 45 W 119 links
"BT"

No other witnesses available

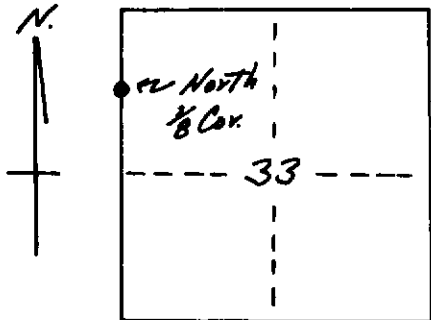

DESCRIPTION IN DETAIL AS TO HOW CORNER WAS LOCATED AND IDENTIFIED OR RESTORED.

Established 1/8 corner midway and on line between 1/4 corner between Sec.'s 32-33 and section corner common to Sec.'s 28-29-32-33.

Corner lies in open marsh.

Corner placed and witnessed January 3, 1958.

SURVEYORS SEAL

SIGNED

Billy D. Buckler
REGISTERED LAND SURVEYOR

DATE 1/13/58