

MICHIGAN  
DEPARTMENT OF CONSERVATION  
FORESTRY DIVISION

LAND CORNER RECORD

T. 41. NR. 28 N.

Dickinson COUNTY

DESCRIPTION OF CORNER South 1/8 corner between Sec.'s 33-34


DESCRIPTION OF CORNER MONUMENT 1" x 48" iron pipe

WITNESSES TO CORNER 5" B. Spruce S 88° E 29 links

"BT"

6" B. Spruce S 39° W 29 links

"BT"

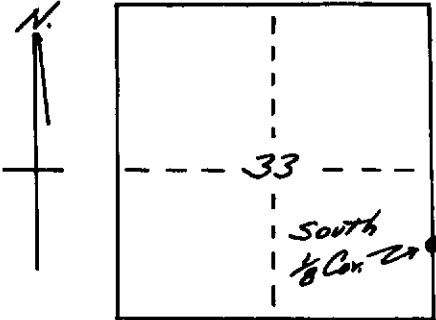

DESCRIPTION IN DETAIL AS TO HOW CORNER WAS LOCATED AND IDENTIFIED OR RESTORED.

Placed 1/8 corner midway and on line between 1/4 corner between Sec.'s 33-34 and south section corner common to Sec.'s 33-34.

Corner lies in swamp.

SURVEYORS SEAL

SIGNED Billy D. Buckles DATE 1/13/58  
REGISTERED LAND SURVEYOR