

MICHIGAN
DEPARTMENT OF CONSERVATION
FORESTRY DIVISION

LAND CORNER RECORD

T. 41 NR. 28 W.


Dickinson COUNTY

DESCRIPTION OF CORNER South 1/8 corner between Sec.'s 32-33

DESCRIPTION OF CORNER MONUMENT 1" x 48" iron pipe

WITNESSES TO CORNER 8" Aspen S 70° W 8 links
"BT"

36" W. Pine stub N 32° E 45 links
"BT"

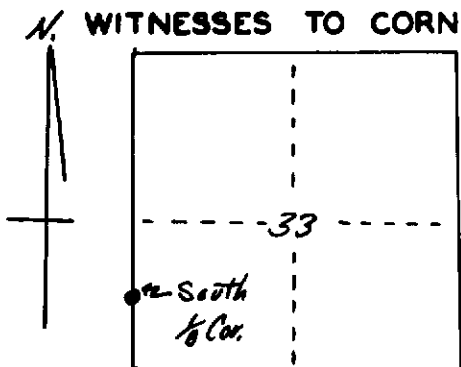

DESCRIPTION IN DETAIL AS TO HOW CORNER WAS LOCATED AND IDENTIFIED OR RESTORED.

Placed 1/8 corner midway and on line between section corner 32-33 to south and 1/4 corner between 32-33 to north.

Corner placed and witnessed January 9, 1958.

SURVEYORS SEAL

SIGNED Billy D. Buckler DATE 1/21/58
REGISTERED LAND SURVEYOR