

MICHIGAN
DEPARTMENT OF CONSERVATION
FORESTRY DIVISION

LAND CORNER RECORD

T. 41 NR 28 W


Dickinson COUNTY

DESCRIPTION OF CORNER East 1/8 corner of Sec. 33

DESCRIPTION OF CORNER MONUMENT 1" x 48" iron pipe

WITNESSES TO CORNER 4" Tamarack S 17° E 27 links
"B.T."

6" Tamarack S 46° E 43½ links
"B.T."

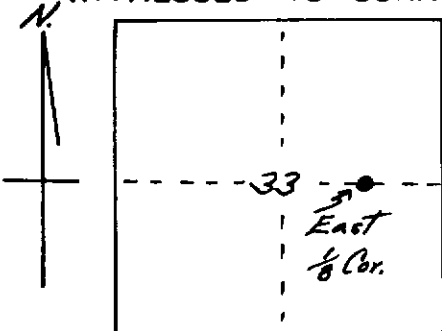

DESCRIPTION IN DETAIL AS TO HOW CORNER WAS LOCATED AND IDENTIFIED OR RESTORED.

Placed 1/8 corner midway between center of section and east 1/4 corner.

Corner placed and witnessed January 9, 1958.

SURVEYORS SEAL

SIGNED Billy D. Buckles DATE 1/21/58
REGISTERED LAND SURVEYOR