

LAND CORNER RECORDATION CERTIFICATE
 Filing Requirement of Act 74, Mich. P.A. 1970 as Amended

For corners in

<u>Dickinson</u> (County)	Located In:	Corner Code #
<u>NORWAY TOWNSHIP</u>		
1. Public Land Survey	T _____ R _____	_____
	T _____ R _____	_____
	T _____ R _____	_____
2. Property Controlling Section	S <u>33</u> T <u>41N</u> R <u>29W</u>	<u>03</u>
	S <u>33</u> T <u>41N</u> R <u>29W</u>	<u>04</u>
	S _____ T _____ R _____	_____
3. Miscellaneous Property in Sec.	S _____ T _____ R _____	_____
	S _____ T _____ R _____	_____

4. Lot No. _____, Recorded Plat _____
 5. Private Claims _____

11/08/2012AD

, Jeremy J. Pipp, in a field survey on 11/08/2012AD do hereby state that under requirements of P.A. 74, Michigan P.A. of 1970, the corner points mentioned in lines 1 and 2 above were in conformance with regulations and rules therefore as required in the current manual of survey instructions of the United States Department of the Interior, Bureau of Land Management or by a decree of a Court of Law and /or that the corner points mentioned in lines 3, 4 and 5 above were in conformance with the rules of the Michigan Board of Land Surveyors or by a Decree of a Court of Law; established, re-established, monumented, recovered, found as expressed below:

Register of Deeds Stamp & File Number

	A	B	C	D	E	F	G	H	I	J	K	L	M
1													
2	6		5		4		3		2		1		
3													
4	7		8		9		10		11		12		
5													
6	18		17		16		15		14		13		
7													
8	19		20		21		22		23		24		
9													
10	30		29		28		27		26		25		
11													
12	31		32		33		34		35		36		
13													

NOTE: Not more than 2 corners, all in the same town and range, may be recorded on this certificate.

A. Description of original monument and accessories and/or subsequent restoration:

(03) North One-Sixteenth corner common to Sections 32 and 33. Not set in original survey, no evidence of subsequent establishment.

(04) Northwest One-Sixteenth corner of Section 33. Not set in original survey, no evidence of subsequent establishment.

B. Description of corner evidence found and/or method applied in restoring or reestablishing corner:

(03) Corner position established mid-point and on-line between the West One-Quarter corner and the Northwest corner of Section 33.

(04) Corner position established at the intersection of the North and West One-Sixteenth lines of Section 33.

C. Description of monument for corner and accessories established to perpetuate locating the position of the corner:

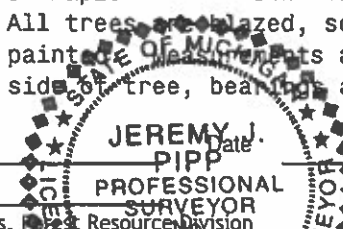
(03) DNR monument
 4" Ironwood N35E 17.06' (1/16S,BT)
 13" Maple S86E 24.03' (1/16S,BT)
 5" Ironwood S34W 38.86' (1/16S,BT)
 5" Ash N79W 39.92' (1/16S,BT)

All trees are blazed, scribed, and painted. Measurements are to nail in side of tree, bearings are magnetic.

(04) DNR monument
 8" Ironwood N27E 31.93' (1/16S,BT)
 8" Maple S89E 36.25' (1/16S,BT)
 7" Maple S26W 43.52' (1/16S,BT)
 6" Maple N84W 15.47' (1/16S,BT)

All trees are blazed, scribed, and painted. Measurements are to nail in side of tree, bearings are magnetic.

Signed by Jeremy J. Pipp
 Surveyor's Michigan License No. 50447


 Date: July 18, 2013
 JEREMY J. PIPP
 PROFESSIONAL SURVEYOR
 MICHIGAN DEPARTMENT OF NATURAL RESOURCES
 PROFESSIONAL SURVEYOR DIVISION

For the Michigan Department of Natural Resources, Professional Surveyor Division

20136

20137