

40N 29W H1
40N 29W I1

LAND CORNER RECORDATION CERTIFICATE
Filing Requirement of Act 74, Mich. P.A. 1970

RECORDED

1999 NOV 30 PM 3:31

For corners in

DICKINSON Located In: _____ Corner Code # _____
(County)
NORWAY TOWNSHIP

- | | | |
|------------------------------------|-------------------------|-------------|
| 1. Public Land Survey | T <u>41 N R 29 W</u> | <u>H-13</u> |
| | T <u>41 N R 29 W</u> | <u>I-13</u> |
| | T _____ R _____ | _____ |
| | T _____ R _____ | _____ |
| 2. Property Controlling in Section | S _____ T _____ R _____ | _____ |
| | S _____ T _____ R _____ | _____ |
| 3. Miscellaneous Property in Sec. | S _____ T _____ R _____ | _____ |
| | S _____ T _____ R _____ | _____ |

REGISTER OF DEEDS
DICKINSON COUNTY
RON STABLEMAN 3049001

Register of Deeds Stamp & File Number

MAR 24 2000

4. Lot No. _____, Recorded Plat _____
5. Private Claims _____ SECTION _____

I, JAMES H. MOORE, in a field survey on SEPTEMBER 9 & OCTOBER 13, 19 99 do hereby state that under requirements of P.A. 74, Michigan P.A. of 1970, the corner points mentioned in lines 1 and 2 above were in conformance with regulations and rules therefore as required in the current manual of survey instructions of the United States Department of the Interior, Bureau of Land Management or by a decree of a Court of Law and /or that the corner points mentioned in lines 3, 4 and 5 above were in conformance with the rules of the Michigan Board of Land Surveyors or by a Decree of a Court of Law; established, re-established, monumented, recovered, found as expressed below:

	A	B	C	D	E	F	G	H	I	J	K	L	M
1													
2	6		5		4		3		2		1		
3													
4	7		8		9		10		11		12		
5													
6	18		17		16		15		14		13		
7													
8	19		20		21		22		23		24		
9													
10	30		29		28		27		26		25		
11													
12	31		32		33		34		35		36		
13													

NOTE: Not more than 2 corners, all in the same town and range, may be recorded on this certificate.

A. Description of original monument and accessories and/or subsequent restoration:

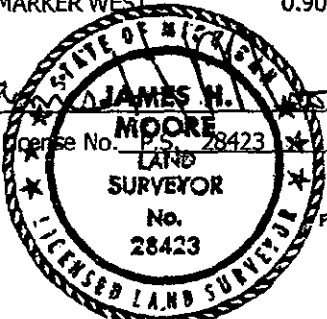
- | | |
|--|--|
| <u>H-13</u> SOUTH 1/4 CORNER OF SECTION 34
FOUND 10" CEDAR PER AUSTIN BURT, D.S. 1846 | <u>I-13</u> CORNER COMMON TO SECTIONS 34-35, T41N-R29W
CEDAR POST BY AUSTIN BURT, D.S. 1846 |
| USED 10" CEDAR AS CORNER.
NO WITNESSES SET | HEMLOCK 14" N 41° E 30 LINKS
HEMLOCK 14" N 48° W 22 LINKS |

B. Description of corner evidence found and/or method applied in restoring or reestablishing corner:

- | | |
|--|--|
| <u>H-13</u> FOUND 1" PIPE WITH 4" MICHIGAN DEPARTMENT OF CONSERVATION BRASS CAP, SET BY DEAN DE LA MATER R.L.S. # 13030 FOUND 2 EXISTING CEDAR B.T.'S IN POOR CONDITION. | <u>I-13</u> FOUND 1" PIPE WITH 4" MICHIGAN DEPARTMENT OF CONSERVATION BRASS CAP, SET BY DEAN DE LA MATER R.L.S. # 13030. |
| 1954 BEARING TREES
14" CEDAR S 48° W 25 LINKS
12" CEDAR S 40° E 29 LINKS | NO WITNESSES SET IN 1954. |

C. Description of monument for corner and accessories established to perpetuate locating the position of the corner:

- | | |
|---|---|
| <u>H-13</u> FOUND ABOVE DESCRIBED MONUMENT IN PLACE.
NEW WITNESSES. | <u>I-13</u> FOUND ABOVE DESCRIBED MONUMENT IN PLACE
NEW WITNESSES. |
| 8" WHITE BIRCH NORTH (M.B.) 32.60' NAIL/TAG
5" HARD MAPLE S 73° E (M.B.) 49.55' NAIL/TAG
12" CEDAR S 19° E (M.B.) 45.49' NAIL/TAG
12" BLACK SPRUCE S 75° W (M.B.) 25.63' NAIL/TAG
CARSONITE MARKER WEST 0.90' | 8" SPRUCE N 08° E (M.B.) 22.60' NAIL/TAG
3" BALSAM S 13° E (M.B.) 12.50' NAIL/TAG
6" BALSAM S 30° E (M.B.) 12.40' NAIL/TAG
2" CHERRY S 55° W (M.B.) 8.15' NAIL/TAG
CARSONITE MARKER S 65° E 1.15' |

Signed by JAMES H. MOORE Date 11-8-99
Surveyor's Michigan License No. 28423


FORM APPROVED BY MICHIGAN STATE BOARD OF PROFESSIONAL SURVEYORS, JAN. 28, 1971
REVISED MAY 14, 1975
REVISED JAN., 1983
REVISED OCT., 1995

ACCEPTED BY THE DICKINSON COUNTY SURVEYOR GROUP AS THE OFFICIAL CORNER UNDER MICHIGAN PUBLIC ACT 345 OF 1990 AT A MEETING HELD ON 11-23-99
Robert J. [Signature]
COUNTY REPRESENTATIVE

Liber 3 PAGE 11