

RECORDED

1993 DEC 20 PM 2:34

LAND CORNER RECORDATION CERTIFICATE
Filing Requirement of Act 74, Mich. P.A. 1970

For corners in

Dickinson (County) Located In: Corner Code #
1. Public Land Survey T 41 N R 29 W I-6
T 41 N R 29 W J-7
T 41 N R 29 W K-5
T 41 N R 29 W K-6
2. Property Controlling in Section S T R
3. Miscellaneous Property in Sec. S T R
4. Lot No. Recorded Plat
5. Private Claims

REGISTER OF DEEDS
DICKINSON COUNTY
RON YOUNG, CLERK

ACCEPTED BY THE DICKINSON COUNTY
SURVEY PEER GROUP AS THE OFFICIAL
CORNER UNDER MICHIGAN PUBLIC ACT
345 OF 1990 AT A MEETING HELD ON

6-7-94
RTP

COUNTY REPRESENTATIVE

Register of Deeds Stamp & File Number

I, Ewart C. Muller, in a field survey on October, 19 93, do hereby certify that under requirements of P.A. 74, Michigan P.A. of 1970, the corner points mentioned in lines 1 and 2 above were in conformance with regulations and rules therefore as required in the current manual of survey instructions of the United States Department of the Interior, Bureau of Land Management or by a decree of a Court of Law and/or that the corner points mentioned in lines 3, 4 and 5 above were in conformance with the rules of the Michigan Board of Land Surveyors or by a Decree of a Court of Law; established, re-established, monumented, re-monumented, recovered, found as expressed below:


NOTE: Not more than 4 corners, all in the same town and range, may be recorded on this certificate.

Grid table with columns A-M and rows 2-13. Contains numerical values and symbols (dots) at specific grid intersections.

- A. Description of original monument and accessories and/or subsequent restoration: John Burt/Lucius Lyon 4/27/1849
I-6 Original Witnesses: Set post Quarter section corner between Sections 14 & 15. Cedar 12 S78W 19 lks: Cedar 8 N61E 12 lks.
J-7 Original Witnesses: Set cedar post Quarter section corner between Sections 14 & 23. Hemlock 20 N61E 34 lks: Y. Pine S62W 10 lks.
K-5 Original Witnesses: Set cedar post corner of Sections 11,12,13 & 14. Cedar 10 N67W 17 lks: Cedar 14 S54E 15 lks.
K-6 Original Witnesses: Set cedar post Quarter section corner between Sections 13 & 14. Cedar 24 N47W 12 lks: Cedar 30 S32E 18 lks.
B. Description of corner evidence found and/or method applied in restoring or reestablishing corner:
I-6 DNR NBT's: Set one-inch iron pipe/brass cap midway on line between Section corners North & South. Tamarack 10 S76E 20 lks(fd./down): Cedar 9 S26W 40 lks(fd.): Cedar 7 N34E 36 lks(fd.)
J-7 DNR NBT's: Set one-inch iron pipe/brass cap midway on line between Section corners East & West. Aspen 12 N76E 10 lks(fd. stump): Aspen 8 West 41 lks(fd. stump).
K-5 DNR NBT's: Set one-inch iron pipe/brass cap by double proportion? Section corners North, East, South & West. 8-inch squared/scribed maple at corner: H.Mpl 8 N47W 27 lks(fd.): H.Mpl 8 N43E 37 lks(fd.)
K-6 DNR NBT's: Set one-inch iron pipe/brass cap midway on line between Section corners North & South. Y. Pine Stub 24 S56W 43 lks(fd./down): Balsam 7 N27W 69 lks(fd./dead)
C. Description of monument for corner and accessories established to perpetuate locating the position of the corner: Magnetic Bearings.
I-6 Found DNR iron pipe/brass cap & post. [Measurements to 16d nail in notch/side of tree]. NBT's: Cedar 10 S28W 26.85: Cedar 8 N38E 24.25: Cedar 9 S22E 29.75: Cedar 7 N36W 9.75
J-7 Found DNR iron pipe/brass cap southeast of intersection of fire lanes. NBT's: R. Pine 11 S25W 77.70: R.Pine 9 S42E 52.85: Aspen 6 N60W 45.40: Aspen 5 N16E 42.10.
K-5 Found DNR iron pipe/brass cap at squared/scribed H.Maple. NBT's: H.Mpl 10 N47W 18.25: H.Mpl 12 N44E 24.75: H.Mpl 7 East 34.40: Squared Mpl 13 S42W 1.90.
K-6 Found DNR iron pipe/brass cap. NBT's: Spruce 5 N78E 14.35: Spruce 8 N88W 44.83: Spruce 10 S74W 48.60: B. Ash 3 N48W 7.53.

Signed by Ewart C Muller Date December 17, 1993

Surveyor's Michigan License No. 15408

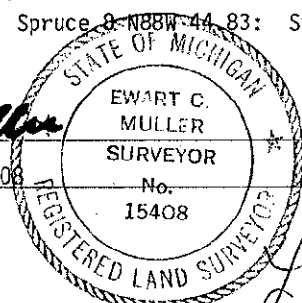

Lib 2 Page 73