

ACCEPTED BY THE DICKINSON COUNTY SURVEY PLEER GROUP AS THE OFFICIAL CORNER UNDER MICHIGAN PUBLIC ACT 345 OF 1990 AT A MEETING HELD ON 6-7-94
 R.F.P.
 COUNTY REPRESENTATIVE

LAND CORNER RECORDATION CERTIFICATE
 Filing Requirement of Act 74, Mich. P.A. 1970

REGISTERED OF DEEDS
 DICKINSON COUNTY
 1003 DEC - 1 AM 11: 09
 RECORDED

For corners in Dickinson (County) Located In: _____ Corner Code ##

1. Public Land Survey	T	L1N	R	29W	K-9
	T	"	R	"	L-9
	T	"	R	"	M-9
	T		R		
2. Property Controlling in Section	S		T	R	
	S		T	R	
3. Miscellaneous Property in Sec.	S		T	R	
	S		T	R	

4. Lot No. _____, Recorded Plat _____

5. Private Claims _____

Register of Deeds Stamp & File Number


I, Edward Kazianka, in a field survey on Oct. 12, 19 93, do hereby certify that under requirements of P.A. 74, Michigan P.A. of 1970, the corner points mentioned in lines 1 and 2 above were in conformance with regulations and rules therefore as required in the current manual of survey instructions of the United States Department of the Interior, Bureau of Land Management or by a decree of a Court of Law and/or that the corner points mentioned in lines 3, 4 and 5 above were in conformance with the rules of the Michigan Board of Land Surveyors or by a Decree of a Court of Law; established, re-established, monumented, re-monumented, recovered, found as expressed below:

A	B	C	D	E	F	G	H	I	J	K	L	M
2	6		5		4		3		2			
3												
4	7		8		9		10		11		12	
5												
6	18		17		16		15		14		13	
7												
8	19		20		21		22		23		24	
9												
10	30		29		28		27		26		25	
11												
12	31		32		33		34		35		36	
13												

NOTE: Not more than 4 corners, all in the same town and range, may be recorded on this certificate.

- A. Description of original monument and accessories and/or subsequent restoration:
- K-9 Wood Post W. Pine 12 N63W 34 lks. W. Pine 12 S63W 49 lks. Dept. of Conservation Brass Cap on iron pipe. 4-29-60 W. Pine 20 S45W 3.96 chains. No other trees.
 - L-9 Wood Post Spruce 8 N80E 40 lks. Tamarack 16 S11W 60 lks.
 - M-9 Wood Post W. Pine 30 S86E 38 lks. W. Pine 24 N35W 30 lks. Dept. of Conservation Brass cap on iron pipe. 4-29-60 Aspen 6 S52E 26 lks. W. Birch 8 N38W 38 lks. Pine snag 24 N40E 38 lks.
- B. Description of corner evidence found and/or method applied in restoring or reestablishing corner:
- K-9 Dept of Conservation Brass cap and iron pipe.
 - L-9 No evidence of original corner or accessories found. Set Quarter Corner by proportionate measurement at mid-point and on line between section corners 1/2 mile to the east and west.
 - M-9 Dept. of Conservation Brass cap & iron pipe.
- C. Description of monument for corner and accessories established to perpetuate locating the position of the corner:
- K-9 Dept. of Conservation corner. W. Pine 28 S48W 3.96 Chains. Tamarack 2 N23W 39.12 feet. Tamarack 2 S65W 56.10 feet. " 6 S26E 139.77 feet.
 - L-9 2 inch Alum cap on a 5 foot # 6 re-rod set in north edge of flooded stream. Cedar 22 N02W 41.95 feet. B. Ash 7 N65W 59.55 feet. B. Ash 12 S04W 65.93 feet. " 11 S34E 73.15 feet.
 - M-9 Dept. of Conservation corner. W. Birch 13 N38W 38 lks. Maple 11 S63W 30.35 feet. Aspen 10 S15W 13.70 feet. Aspen 8 N52E 13.15 feet. Spruce 10 N12W 25.05 feet.

Signed by Edward Kazianka Date Nov. 3, 1993
 Surveyor's Michigan License No. 94765

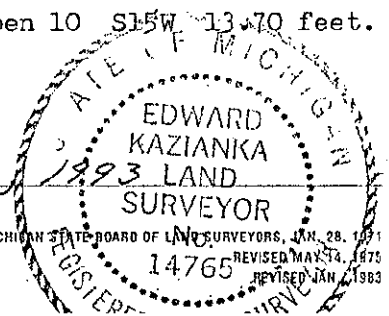

LIBER 2 PAGE 72