

Common to:  
 K-13 M-1 T40 29  
 (K-13) (M-13) A13 41-28

M-13/A-13 T41N-R28W

**LAND CORNER RECORDATION CERTIFICATE**  
**Filing Requirement of Act 74, Mich. P.A. 1970**

RECORDED

1999 NOV 30 PM 3:31

For corners in

DICKINSON  
 (County)  
 NORWAY TOWNSHIP

Located In:

Corner Code #

- |                                    |                         |                          |
|------------------------------------|-------------------------|--------------------------|
| 1. Public Land Survey              | T 41 N R 29 W           | K-13                     |
|                                    | T 41 N R 29 W           | M-13                     |
|                                    | T _____ R _____         |                          |
|                                    | T _____ R _____         |                          |
| 2. Property Controlling in Section | S _____ T _____ R _____ |                          |
|                                    | S _____ T _____ R _____ |                          |
| 3. Miscellaneous Property in Sec.  | S _____ T _____ R _____ | SURVEY & REMONUMENTATION |

REGISTER OF DEEDS  
 DICKINSON COUNTY  
 RON MOORE, CLERK

Register of Deeds Stamp & File Number

4. Lot No. \_\_\_\_\_, Recorded Plat MAR 24 2000
5. Private Claims \_\_\_\_\_ SECTION \_\_\_\_\_

I, JAMES H. MOORE, in a field survey on SEPTEMBER 2, 19 99 do hereby state that under requirements of P.A. 74, Michigan P.A. of 1970, the corner points mentioned in lines 1 and 2 above were in conformance with regulations and rules therefore as required in the current manual of survey instructions of the United States Department of the Interior, Bureau of Land Management or by a decree of a Court of Law and /or that the corner points mentioned in lines 3, 4 and 5 above were in conformance with the rules of the Michigan Board of Land Surveyors or by a Decree of a Court of Law; established, re-established, monumented, recovered, found as expressed below:

**NOTE: Not more than 2 corners, all in the same town and range, may be recorded on this certificate.**

	A	B	C	D	E	F	G	H	I	J	K	L	M	
1														
2	6			5			4			3			2	1
3														
4	7			8			9			10			11	12
5														
6	18			17			16			15			14	13
7														
8	19			20			21			22			23	24
9														
10	30			29			28			27			26	25
11														
12	31			32			33			34			35	36
13														

A. Description of original monument and accessories and/or subsequent restoration:

K-13 CORNER COMMON TO SECTIONS 35-36, T41N-R29W  
 CEDAR POST BY AUSTIN BURT, D.S. 1846  
 PINE 14" N 50° E 16 LINKS  
 CEDAR 7" N 20° W 27 LINKS

M-13 CORNER COMMON TO SECTIONS 31-36, T41N-R28 & 29 W  
 CEDAR POST BY AUSTIN BURT, D.S. 1846  
 WHITE PINE 40" N 72° E 48 LINKS  
 CEDAR 14" N 25° W 17 LINKS

B. Description of corner evidence found and/or method applied in restoring or reestablishing corner:

K-13 FOUND 1" PIPE WITH 4" MICHIGAN DEPARTMENT OF CONSERVATION BRASS CAP, SET BY DEAN DE LA MATER R.L.S. #13030.

M-13 FOUND 1" PIPE WITH 4" MICHIGAN DEPARTMENT OF CONSERVATION BRASS CAP, SET BY BILL BUCKLER R.L.S. #08887

1951 BEARING TREES  
 10" CEDAR N 60° W 28 LINKS  
 8" RED OAK S 49° W 46 LINKS

1956 BEARING TREES  
 9" ASPEN N 58° W 9 LINKS  
 7" BALSAM N 74° E 26 LINKS


C. Description of monument for corner and accessories established to perpetuate locating the position of the corner:

K-13 FOUND ABOVE DESCRIBED MONUMENT IN PLACE  
 NEW WITNESSES  
 8" MAPLE N 63° E (M.B.) 17.10' NAIL/TAG  
 6" MAPLE S 37° E (M.B.) 11.12' NAIL/TAG  
 FOUND 16" RED OAK S 51° W (M.B.) 30.48' NAIL/TAG  
 8" MAPLE N 69° W (M.B.) 43.65' NAIL/TAG  
 CARSONITE MARKER SOUTH 0.80'

M-13 FOUND ABOVE DESCRIBED MONUMENT IN PLACE  
 NEW WITNESSES  
 5" ASPEN N 20° E (M.B.) 16.64' NAIL/TAG  
 5" ASPEN S 86° E (M.B.) 7.20' NAIL/TAG  
 4" ASPEN S 25° W (M.B.) 12.18' NAIL/TAG  
 5" ASPEN S 77° W (M.B.) 28.78' NAIL/TAG  
 14" CEDAR N 59° W (M.B.) 56.39' NAIL/TAG  
 CARSONITE MARKER N 15° W 0.70'

Signed by JAMES H. MOORE  
 Surveyor's Michigan License No. P.S. 28423

Date 11-8-99

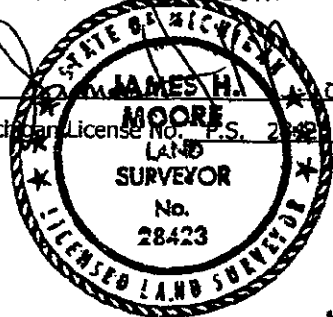

FORM APPROVED BY MICHIGAN STATE BOARD OF PROFESSIONAL SURVEYORS, JAN. 28, 1971

REVISED MAY 14, 1975

REVISED JAN., 1983

REVISED OCT., 1995

ACCEPTED BY THE DICKINSON COUNTY SURVEY PEER GROUP AS THE OFFICIAL CORNER UNDER MICHIGAN PUBLIC ACT 345 OF 1990 AT A MEETING HELD ON

11-23-99  
[Signature]  
 COUNTY REPRESENTATIVE

Liber 3 PAGE 9