

MICHIGAN
DEPARTMENT OF CONSERVATION
FORESTRY DIVISION

LAND CORNER RECORD

T. 41. NR. 29. W.


Dickinson COUNTY

DESCRIPTION OF CORNER E 1/8 corner for sections 30 and 31

DESCRIPTION OF CORNER MONUMENT 1" Iron Pipe 4' long

WITNESSES TO CORNER 10" Tamarack (BT) N 35° W 42 Links

24" W. Pine (BT) S 39° E 112 Links

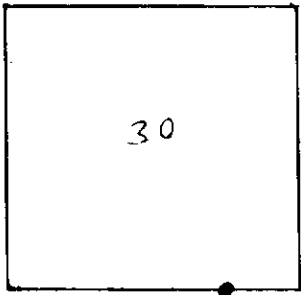

DESCRIPTION IN DETAIL AS TO HOW CORNER WAS LOCATED AND IDENTIFIED OR RESTORED. This corner was established midway and on line between section corners for sections 30, 29, 31, 32 and 1/4 corner for sections 30 and 31.

Corner was placed and witnessed June 2, 1960 with Bray, Peterson and Potter.

SURVEYORS SEAL

SIGNED Billy D. Buckler DATE 9/13/60
REGISTERED LAND SURVEYOR
Billy D. Buckler