

A-13/A-1 T 41 N R 30 W

LAND CORNER RECORDATION CERTIFICATE
Filing Requirement of Act 74, Mich. P.A. 1970

RECORDED

1999 NOV 30 PM 3:23

For corners in

DICKINSON

(County)

Located In:

Corner Code #

SAGOLA TOWNSHIP

1. Public Land Survey

T 42 N R 30 W

A-13

T 42 N R 30 W

A-11

T R

T R

SURVEY &

2. Property Controlling in Section

S

T R

REMONUMENTATION

S

T R

3. Miscellaneous Property in Sec.

S

T R

S

T R

MAR 24 2000

REGISTERED DEEDS
DICKINSON COUNTY, MICHIGAN

Register of Deeds Stamp & File Number

SECTION

4. Lot No. , Recorded Plat

5. Private Claims

I, JAMES H. MOORE, in a field survey on AUGUST 17, 19 99 do hereby state that under requirements of P.A. 74, Michigan P.A. of 1970, the corner points mentioned in lines 1 and 2 above were in conformance with regulations and rules therefore as required in the current manual of survey instructions of the United States Department of the Interior, Bureau of Land Management or by a decree of a Court of Law and /or that the corner points mentioned in lines 3, 4 and 5 above were in conformance with the rules of the Michigan Board of Land Surveyors or by a Decree of a Court of Law; established, reestablished, monumented, recovered, found as expressed below:

NOTE: Not more than 2 corners, all in the same town and range, may be recorded on this certificate.

Grid table with columns A-L and rows 1-13. Contains numbers 1-36 in a grid pattern.

A. Description of original monument and accessories and/or subsequent restoration:

A-13 CORNER COMMON TO TOWNSHIPS 41 AND 42 NORTH, RANGE 30 AND 31 WEST POST BY WILLIAM BURT, D.S. 1846 CEDAR 18" S75°E 15 LINKS YELLOW BIRCH 12" N73°W 21 LINKS

A-11 CORNER COMMON TO SECTIONS 30-31 (T42N-R30W) AND SECTIONS 25-26 (T42N-R31W) SPRUCE POST BY WILLIAM BURT, D.S. 1846 YELLOW BIRCH 10" S 72° W 34 LINKS YELLOW BIRCH 14" N 22° W 27 LINKS

B. Description of corner evidence found and/or method applied in restoring or reestablishing corner:

A-13 FOUND KIMBERLY-CLARKE CORP. 4" ALUMINUM CAP, SPERHAKE, RLS 7876, DATE STAMPED 5-5-60.

A-11 FOUND KIMBERLY-CLARKE CORP. 4" ALUMINUM CAP SPERHAKE, RLS 7876, DATE STAMPED 5-23-60.

1960 BEARING TREES MAPLE 5" N50°E 46 LINKS BASSWOOD 7" N44°W 71 LINKS HEMLOCK 16" S71°W 71 LINKS SPRUCE 9" S46°E 70 LINKS

1960 BEARING TREES WHITE PINE 17" N39°E 142 LINKS SPRUCE 12" N18°W 100 LINKS POPLAR 4" S31°W 87 LINKS POPLAR 3" S50°E 35 LINKS

C. Description of monument for corner and accessories established to perpetuate locating the position of the corner:


A-13 FOUND ABOVE DESCRIBED MONUMENT IN PLACE NEW WITNESSES

A-11 FOUND ABOVE DESCRIBED MONUMENT IN PLACE NEW WITNESSES

7" MAPLE S48° W (M.B.) 9.59' NAIL/TAG 5" ASH S30° E (M.B.) 19.90' NAIL/TAG 7" MAPLE N33° E (M.B.) 15.23' NAIL/TAG 7" MAPLE N 30° W (M.B.) 19.30' NAIL/TAG CARSONITE MARKER NORTH 1.44'

FOUND 10" POPLAR STUMP S 35° W (M.B.) 57.42' (DEAD) FOUND 14" SPRUCE N14°W (M.B.) 65.71' NAIL/TAG 10" RED PINE S74°W (M.B.) 53.94' NAIL/TAG 14" POPLAR S31°W (M.B.) 59.21' NAIL/TAG 12" SPRUCE EAST (M.B.) 5.64' NAIL/TAG CARSONITE MARKER NORTH 1.3'

Signed by

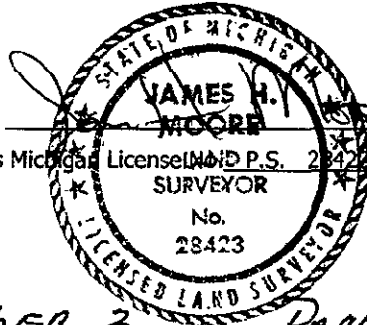

Date 11-8-99

Surveyor's Michigan License No. P.S. 28423

ACCEPTED BY THE DICKINSON COUNTY SURVEY PEER GROUP AS THE OFFICIAL CORNER UNDER MICHIGAN PUBLIC ACT 345 OF 1990 AT A MEETING HELD ON 11-23-99

REVISED MAY 14, 1975
REVISED JAN., 1983
REVISED OCT., 1995

COUNTY REPRESENTATIVE

Liber 3 PAGE 20